


Give All Information Completely
Make Required Affidavit
Mail or Deliver Report to:
Conservation Division
State Corporation Commission
211 No. Broadway
Wichita, Kansas

WELL PLUGGING RECORD

NORTH

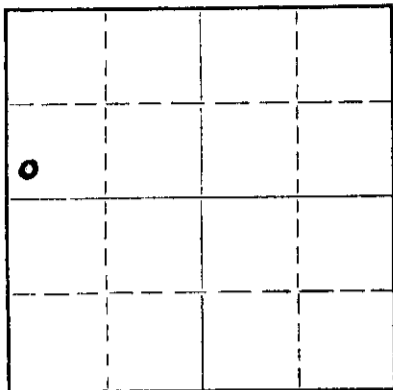

Locate well correctly on above
Section Plat

Saline County. Sec. 28 Twp. 16 Rge. I (E) 1 (W)
Location as "NE/CNW&SW" or footage from lines SW SW NW
Lease Owner F. S. Williams
Lease Name Michael Karber Well No. 1
Office Address Mills Bldg, McPherson, Kansas
Character of Well (completed as Oil, Gas or Dry Hole) Dry Hole
Date well completed 11/7 19 63
Application for plugging filed 11/7 19 63
Application for plugging approved " 19 63
Plugging commenced " 19 63
Plugging completed " 19 63
Reason for abandonment of well or producing formation Dry Hole

If a producing well is abandoned, date of last production 19
Was permission obtained from the Conservation Division or its agents before plugging was commenced? yes

Name of Conservation Agent who supervised plugging of this well Gilbert Toman
Producing formation Depth to top Bottom Total Depth of Well 2672 Feet
Show depth and thickness of all water, oil and gas formations.

OIL, GAS OR WATER RECORDS

CASING RECORD

FORMATION	CONTENT	FROM	TO	SIZE	PUT IN	PULLED OUT
				8 5/8"	145'	none

Describe in detail the manner in which the well was plugged, indicating where the mud fluid was placed and the method or methods used in introducing it into the hole. If cement or other plugs were used, state the character of same and depth placed, from feet to feet for each plug set.

1/2 sack hulls for plug	135'
20 sx cement on plug	
1/2 sack hulls for plug	40'
10 sx cement	5'
surface soil	0'

RECEIVED
STATE CORPORATION COMMISSION

NOV 19 1963

CONSERVATION DIVISION
Wichita, Kansas

(If additional description is necessary, use BACK of this sheet)

Name of Plugging Contractor Melland Drilling Co., Inc.
Address Box 783 McPherson, Kansas

STATE OF Kansas, COUNTY OF McPherson, ss.
Donald J. Melland (employee of owner) or ~~XXXXXX~~ of the above-described well, being first duly sworn on oath, says: That I have knowledge of the facts, statements, and matters herein contained and the log of the above-described well as filed and that the same are true and correct. So help me God.
(Signature) Donald J. Melland
Box 783 McPherson, Kansas
(Address)

SUBSCRIBED AND SWORN TO before me this 11 day of November, 19 63

My commission expires August 24, 1967

Jay E. Mahan
Notary Public.

15-169-00752-0000

WELL RECORD

LEASE: Michael Karber

WELL NO. 1

SEVEN

LOCATION: SW SW NW
Sec. 28-16-1W

ELEVATION:
11/2/63

COMMENCED:
11/7/63

COMPLETED:

OPERATOR: F. S. Williams

CONTRACTOR: Melland Drilling Company, Inc.
Post Office Box 783
McPherson, Kansas

CASING RECORD: 5/8" 143'/100sx

FORMATION	LOG
Shale & Shells	145
Lime & Shale	884
Shale & Shells	1420
Shale & Lime	1685
Lime & Shale	1867
Shale	2010
Lime & Shale	2621
Mississippi Lime	2642
RTD	2642
 Sample Tops	
Mississippi	2621

FORMATION LOG

RECEIVED
STATE CORPORATION COMMISSION


NOV 14 1963

CONSERVATION DIVISION
Wichita, Kansas

CERTIFICATE

State of Kansas, County of McPherson, ss.

I, Donald J. Melland, do hereby certify that the above is a true and correct copy of the log of the above named and described well, as reflected by the records of the Melland Drilling Company, Inc.

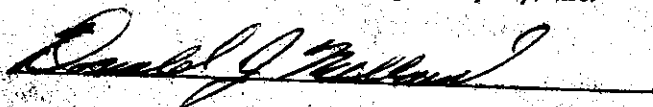

Subscribed and sworn to before me, a Notary Public, in and for the County of McPherson, State of Kansas, this 11 day of November, 19 63

My Commission expires: August 24, 1967


Notary Public