

WELL PLUGGING RECORD

Give All Information Completely
Make Required Affidavit
Mail or Deliver Report to:
Conservation Division
State Corporation Commission
806 Bittling Building
Wichita, Kansas

Saline County, Sec. 28 Twp. 16 Rge. 1 (E) (W)

Location as "NE/CNW $\frac{1}{4}$ SW $\frac{1}{4}$ " or footage from lines SW SE SW

Lease Owner Nicholas Chapro

Lease Name Frank Karber Well No. 1

Office Address c/o F. S. Williams McPherson, Ks.

Character of Well (completed as Oil, Gas or Dry Hole) Dry Hole

Date well completed December 7, 19 51

Application for plugging filed December 6, 19 51

Application for plugging approved December 6, 19 51

Plugging commenced December 7, 19 51


Plugging completed December 7, 19 51

Reason for abandonment of well or producing formation

no commercial production found

If a producing well is abandoned, date of last production 19

Was permission obtained from the Conservation Division or its agents before plugging was commenced? YES

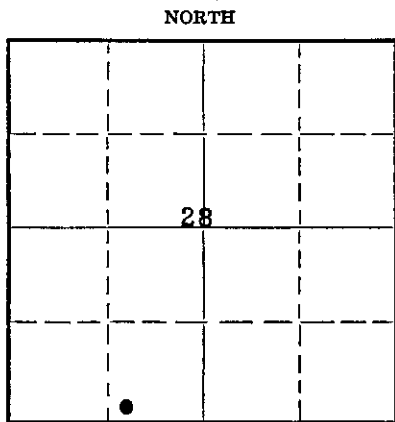

Locate well correctly on above Section Plat

Name of Conservation Agent who supervised plugging of this well Ruel Durkee

Producing formation none Depth to top - Bottom - Total Depth of Well 3332 Feet

Show depth and thickness of all water, oil and gas formations.

OIL, GAS OR WATER RECORDS

Torary Hole

CASING RECORD

Formation	Content	From	To	Size	Put In	Pulled Out
Kansas City	Show Oil--Stem	2002	07	-	-	-
Mississippi	dry	2600	2846	-	-	-
Hunton	dry	2947	3060	-	-	-
Viola	dry	3143	3227	-	-	-
Simpson	dry	3227	3308	-	-	-
Arbuckle	dry	3208	3332	T.D.	-	-

Describe in detail the manner in which the well was plugged, indicating where the mud fluid was placed and the method or methods used in introducing it into the hole. If cement or other plugs were used, state the character of same and depth placed, from 160 feet to surface feet for each plug set.

Bridged hole at 160'

10' rock at 160 - 150

20 Sacks Cement 150 - 90

Mud, Heavy 90 - 25

Bridge hole at 25' Rocks from 25 - 15

10 Sacks cement 15 - surface

(If additional description is necessary, use BACK of this sheet)

Correspondence regarding this well should be addressed to F. S. Williams

Address McPherson, Ks.

STATE OF McPherson, COUNTY OF Kansas, ss.
F. S. Williams

(employee of owner) or (owner or operator) of the above-described well, being first duly sworn on oath, says: That I have knowledge of the facts, statements, and matters herein contained and the log of the above-described well as filed and that the same are true and correct. So help me God.

(Signature) *F. S. Williams*

McPherson, Ks.

(Address)

SUBSCRIBED AND SWORN to before me this 7th day of December, 19 51.

Rogsh. 2 ty

My commission expires 9-14-1954.

Notary Public.

28-16-16
28-129-31

15-169-00095-0000

DRILLERS LOG

Company Nicholas Chapro & Etal. Commenced 10-18-51
 Contractor Slusser Drilling Co. Completed 12-6-51
 SW SE SW Sec. 28 Twp. 16s Range 1 W. Saline Co. Kansas
 8 5/8 @ 148
 Production Dry

Sandy Soil	20	
Sand	25	
Shale & Shells	100	
Lime	200	
Shale & Shells	220	
Shale & Lime	235	
Lime	380	
Lime & Shale	510	
Shale & Lime	580	
Lime & Shale	680	
Shale & Shells	1220	
Broken Lime & Shale	1259	
Shale & Shells	1435	
Sand	1470	
Lime	1490	
Lime & Shale	1650	
Lime	1815	
Shale	1840	
Sandy Shale	1860	
Shale	1915	
Shale & Shells	1945	
Sandy Shale	1955	
Shale	1990	
Lime	2125	
Lime & Shale	2210	
Lime	2340	
Shale	2350	
Lime & Shale	2600	
Chat	2810	
Cherty Lime	2835	
Lime	2855	
Shale	2947	
Lime	3063	
Shale	3142	
Lime	3215	
Sand & Lime	3285	
Sandy Shale & Lime	3300	
Sand	3310	
Lime	3329	Corrected to 3332 Total Depth.

PLUGGING
 FILE SEC 28 16 11
 BOOK PAGE 129 LINE 31

SEARCHED
 INDEXED
 JAN 21 1952
 COM. DIVISION
 WICHITA, KANSAS