


WELL PLUGGING RECORD

Give All Information Completely
Make Required Affidavit
Mail or Deliver Report to:
Conservation Division
State Corporation Commission
800 Bitting Building
Wichita, Kansas

Saline County, Sec. 23 Twp. 16 Rge. (E) 1 (W)

Location as "NE/CNW%SW%" or footage from lines C NW NW NE
Lease Owner Donald T. Ingling et al
Lease Name Mayer Well No. 1
Office Address Wichita 2, Kansas
Character of Well (completed as Oil, Gas or Dry Hole) Dry Hole
Date well completed December 7, 1955
Application for plugging filed December 7, 1955
Application for plugging approved December 7, 1955
Plugging commenced December 7, 1955
Plugging completed December 7, 1955
Reason for abandonment of well or producing formation Dry

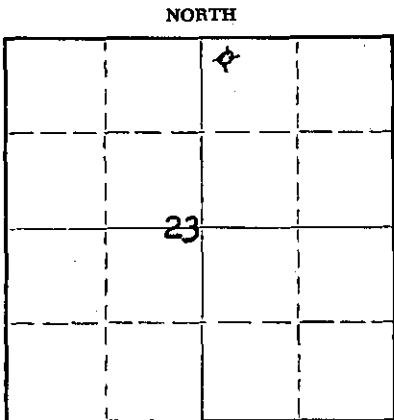

Locate well correctly on above Section Plat

If a producing well is abandoned, date of last production 19
Was permission obtained from the Conservation Division or its agents before plugging was commenced? Yes

Name of Conservation Agent who supervised plugging of this well Ruel Durkee, McPherson, Kansas
Producing formation _____ Depth to top _____ Bottom _____ Total Depth of Well 2695 Feet
Show depth and thickness of all water, oil and gas formations.

OIL, GAS OR WATER RECORDS

CASING RECORD

FORMATION	CONTENT	FROM	TO	SIZE	PUT IN	PULLED OUT
				8 5/8"	93'	None

Describe in detail the manner in which the well was plugged, indicating where the mud fluid was placed and the method or methods used in introducing it into the hole. If cement or other plugs were used, state the character of same and depth placed, from _____ feet to _____ feet for each plug set.

Circulated heavy mud one hour and laid down one-half drill pipe, circulated heavy mud one-half hour and laid down balance of drill pipe. Bottom plug at 90 feet with 15 sacks cement and heavy mud - top plug at 20 feet with 5 sacks cement to surface. Plugging completed

(If additional description is necessary, use BACK of this sheet)

Name of Plugging Contractor Donald T. Ingling
Address 623 1st Nat'l Bank Bldg., Wichita 2, Kansas

STATE OF KANSAS, COUNTY OF SEDGWICK, ss.
D. T. Ingling (employee of owner) or (owner or operator) of the above-described well, being first duly sworn on oath, says: That I have knowledge of the facts, statements, and matters herein contained and the log of the above-described well as filed and that the same are true and correct. So help me God.

(Signature) [Signature]
Wichita, Kansas (Address)

SUBSCRIBED AND SWORN to before me this 8th day of December, 19 55

My commission expires Feb. 27, 1956

[Signature]
Notary Public.
STATE CORPORATION COMMISSION

PLUGGING
FILE SEC 23 T 16 R 1W
BOOK PAGE 32 LINE 39

DEC 9 - 1955
CONSERVATION DIVISION
Wichita, Kansas

Donald T. Ingling et al, Lease Owner

Section 23-16-1W

Donald T. Ingling, Contractor

Location: C NW NW NE

Commenced: 11-25-55

County: Saline

Completed: 12-8-55

Production: Dry

Total Depth: 2695'

Elevation: 1319 DF

Casing: 8 5/8" 93' (60 sacks cement)

Figures below indicate bottom formation

25	clay and shells	2005	lime
30	sand and shale	2024	shale
90	shale and shells	2070	lime
128	shale and shells	2140	lime
205	lime	2190	lime
275	lime	2233	lime
380	lime	2285	lime
450	lime	2320	lime
475	shale and lime	2362	lime
560	sandy lime and shale	2385	lime
605	lime	2425	shale
700	lime	2500	shale
790	lime and shale	2570	shale and lime
830	lime and shale	2635	shale
975	shale and shells	2645	Conglomerate
1185	shale	2675	shale and Conglomerate
1340	shale and shells	2695	Mississippi
1440	shale and shells	2695	Total Depth
1450	lime		
1525	shale and shells		
1545	lime		
1630	lime		
1710	lime		
1770	lime		
1835	lime		
1855	lime		
1915	sand and shale		
1950	shale		
1968	shale		

I certify this is a true and correct copy of the above mentioned well.

PLUGGING
 FILE SEC 23 T 16 R 10
 BOOK PAGE 22 LINE 38



STATE OF KANSAS)
) ss.
 SEDGWICK COUNTY)

Subscribed and sworn to before me, a Notary Public, in said County and State.

My commission expires 2-27-56

