


WELL PLUGGING RECORD

Give All Information Completely
Make Required Affidavit
Mail or Deliver Report to:
Conservation Division
State Corporation Commission
800 Bittling Building
Wichita, Kansas

Saline County, Sec. 19 Twp. 16 Rge. 1W (N) (W)

Location as "NE/CNW $\frac{1}{4}$ SW $\frac{1}{4}$ " or footage from lines _____
Lease Owner West-Wymore & Fincher
Lease Name Redden Well No. 1
Office Address 109 $\frac{1}{2}$ North Santa Fe
Character of Well (completed as Oil, Gas or Dry Hole) Dry Hole
Date well completed April 30 1953
Application for plugging filed June 15 1953
Application for plugging approved June 18 1953
Plugging commenced June 25 1953
Plugging completed June 25 1953
Reason for abandonment of well or producing formation _____

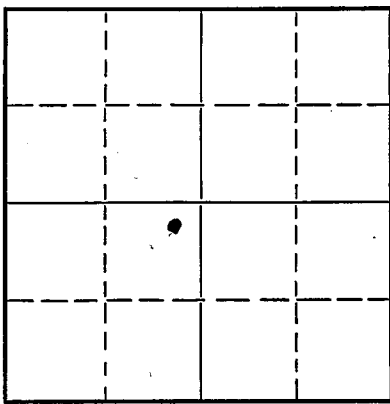

Locate well correctly on above Section Flat

If a producing well is abandoned, date of last production _____ 19____
Was permission obtained from the Conservation Division or its agents before plugging was commenced? Yes

Name of Conservation Agent who supervised plugging of this well Ruel Durkee
Producing formation _____ Depth to top _____ Bottom _____ Total Depth of Well 2735 Feet
Show depth and thickness of all water, oil and gas formations.

OIL, GAS OR WATER RECORDS

CASING RECORD

Formation	Content	From	To	Size	Put In	Pulled Out
				8 3/8	132	0
				5 1/2	2265	1541.70

Describe in detail the manner in which the well was plugged, indicating where the mud fluid was placed and the method or methods used in introducing it into the hole. If cement or other plugs were used, state the character of same and depth placed, from _____ feet to _____ feet for each plug set.

Plugged back with crushed rock from 1897' to 1830'
Dumped 3 sax cement at 1830' with dump bailer. Top
of cement 1815'. Filled hole with mud to 130', set
rock bridge at 130', dumped 15 sax cement. Top of
cement, 85'. Filled with mud to 25', set rock bridge
dumped 5 sax cement for cap.


Name of Plugging Contractor Carl Miller (If additional description is necessary, use BACK of this sheet)
Address Grand Bend, Kansas

STATE OF Kansas, COUNTY OF Saline, ss.
_____, (employee of owner) or (owner or operator) of the above-described well,
being first duly sworn on oath, says: That I have knowledge of the facts, statements, and matters herein contained and the log of the above-described well as filed and that the same are true and correct. So help me God.

(Signature) Loren J. Hallam
Box 566, Salina, Kansas
(Address)

SUBSCRIBED AND SWORN to before me this 5th day of August, 1953.

My commission expires July 31-56
Richard J. Applesin
Notary Public.

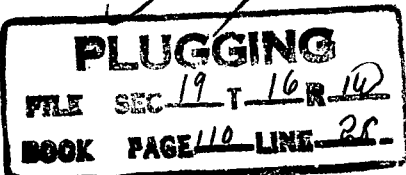

08-07-1953
REGISTRATION DIVISION
Wichita, Kansas

ROTARY DRILLER'S LOG

15-169-00137-0000

Redden #1

Elevation: 1357 R. B.

SE $\frac{1}{4}$ NE $\frac{1}{4}$ SW $\frac{1}{4}$ sec. 19, T16S., R1W.
Saline County, Kansas
Hunter Pool

CASING RECORD
8 5/8"—132'—100 sacks cement
5 1/2"—2,265'—100 Sacks cement

Operator: West & Wymore, et al
109 $\frac{1}{2}$ N. Santa Fe
Salina, Kansas

Contractor: Salina Drilling Corp., Inc.
(Rig #1) Box #566
Salina, Kansas

Well Commenced: April 20, 1953
Well Completed: April 30, 1953

Geologist: Willis D. Waterman
Salina, Kansas

FIGURES INDICATE BOTTOM OF FORMATIONS K.B.

Rotary table, base & cellar	8	Shale & Shells	1725
Clay	30	Lime	1730
Shale & Shells	40	Shale & Shells	1758
Sand & Shale	90	Lime, broken	1800
Shale & Shells	132	Lime	1858
Shale & Shells	185	Toronto lime	1873
Anhydrite	270	Douglas sand	1884
Lime, broken	300	Lime & Shale	1915
Shale & Shells	385	Shale & Shells	1950
Lime shells	580	Shale & Shells	2040
Lime & Shale	800	Lime	2510
Broken lime	825	Shale & lime	2644
Shale & Shells	1140	Conglomerate	2682
Shale	1510	Lime & dolomite	2735


TOPS, etc. as Picked by Geologist

Heebner	1858
Toronto	1873
Douglas Sand	1876
Dodge	2039
Lansing	2093
Miss Chat	2681
Miss Lime	2682

The above Rotary Driller's Log is complete and correct to the best of my knowledge.

SALINA DRILLING CORPORATION, INC.

Loren S. Hallen
President.

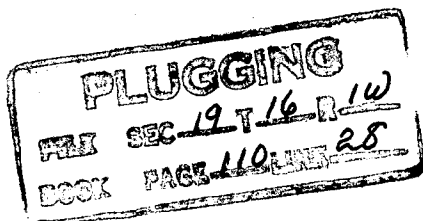

RECEIVED