


Give All Information Completely
Make Required Affidavit
Mail or Deliver Report to:
Conservation Division
State Corporation Commission
800 Bitting Building
Wichita, Kansas

15101-00017-0000
WELL PLUGGING RECORD

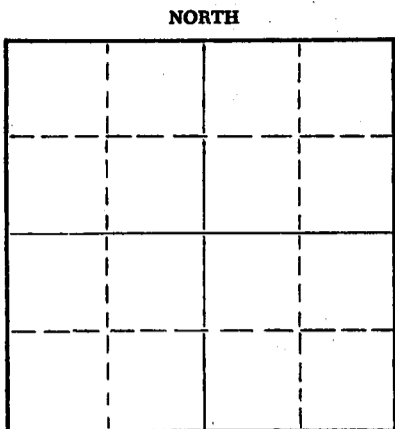

Locate well correctly on above Section Plat

Lane County. Sec. 19 Twp. 17s Rge. 29W(E) (W)
Location as "NE/CNWxSWx" or footage from lines NW NE SW
Lease Owner Jocely and Varn
Lease Name Floyd Well No. 1
Office Address 310 K F H Building - Wichita, Kansas
Character of Well (completed as Oil, Gas or Dry Hole) _____
Date well completed _____ 19____
Application for plugging filed _____ 19____
Application for plugging approved _____ 19____
Plugging commenced August 9 1954
Plugging completed August 14 1954
Reason for abandonment of well or producing formation _____

If a producing well is abandoned, date of last production _____ 19____
Was permission obtained from the Conservation Division or its agents before plugging was commenced? Yes

Name of Conservation Agent who supervised plugging of this well Warren H. Horner
Producing formation _____ Depth to top _____ Bottom _____ Total Depth of Well 4705 Feet
Show depth and thickness of all water, oil and gas formations.

OIL, GAS OR WATER RECORDS

CASING RECORD

FORMATION	CONTENT	FROM	TO	SIZE	PUT IN	PULLED OUT
				5-1/2"	4534'	1799'
				8-8/8"	236'	None

Describe in detail the manner in which the well was plugged, indicating where the mud fluid was placed and the method or methods used in introducing it into the hole. If cement or other plugs were used, state the character of same and depth placed, from _____ feet to _____ feet for each plug set.

A Lane Wells plug was set at 4375' and casing was perforated from 4352' to 4366'. Filled hole with sand from 4375' to 4350' and ran 5 sacks of cement. Mudded hole to 246', set a 10' rock bridge and ran 20 sacks of cement at 236'. Mudded hole to 35' and ran 10 sacks of cement on top. Plugging completed.

(If additional description is necessary, use BACK of this sheet)

Name of Plugging Contractor West Supply Co., Inc.
Address Chase, Kansas

STATE OF Kansas, COUNTY OF Sedgwick, ss.
Stewart Varn (employee of owner) or (owner or operator) of the above-described well, being first duly sworn on oath, says: That I have knowledge of the facts, statements, and matters herein contained and the log of the above-described well as filed and that the same are true and correct. So help me God.

(Signature) [Signature]
310 K F H Bldg. Wichita, Kansas (Address)

SUBSCRIBED AND SWORN TO before me this 13th day of September, 19 54

My commission expires January 30, 1957

[Signature]
Notary Public.

RECEIVED
STATE CORPORATION COMMISSION

PLUGGING
FILED DEC 19 17 R 29W
BOOK PAGE 51 LINE 1

09-14-1954

15-101-00617-0000

LOG

Company: Hougaton Production Company
Contractor: M. B. Armer
Drilling Commenced: 4/1/52
Drilling Completed: 5/7/52

Farm: H. T. Floyd #1
Location: NWc NE SW₄ Sec. 19-17-29
Lane County, Kansas
Casing Record: 8-5/8" casing at 236'
with 200 sacks cement. 5 1/2" casing
at 453 1/4' with 200 sacks cement.

(figures below indicate bottoms)

Clay	45
Sand	60
Shale & clay	85
Sand & gravel	210
Shale & shells	400
Sandy shale	450
Shale & Shells	660
Sand	825
Sandy Shale	960
Shale	1000
Sand	1140
Shale & shells	1460
Sandy shale	1660
Sandy shale & shells	1680
Sandy shale	2000
Sandy shale & redbed	2219
Anhydrite	2246
Shale, redbed & shells	2460
Shale & shells	2875
Shale	2975
Lime & shale	3120
Shale	3160
Shale & lime	3555
Lime	3610
Lime & shale	3750
Lime	3810
Lime & shale	3845
Lime	4211
Lime & shale	4230
Lime	4260
Lime & shale	4295
Lime	4320
Lime & shale	4390
Lime	4423
Lime & shale	4545
Shale & sand	4568
Lime & shale	4590
Lime	4705
R.T.D.	4705

I hereby certify that this is a true and correct log of the above described well as shown by the drilling reports.

RECORDED
09-27-1954
M. B. ARMER

BY [Signature]

CONSERVATION DIVISION
Wichita, Kansas

STATE OF KANSAS)
) ss:
COUNTY OF SEDGWICK)

PLUGGING
FILE SEC 19 T 17 R 29 W
BOOK PAGE 51 LINE 1

Subscribed and sworn to before me, a notary public, in and for said County and State this 9th day of May, 1952.

[Signature]
Notary Public