


WELL PLUGGING RECORD

Give All Information Completely
Make Required Affidavit
Mail or Deliver Report to:
Conservation Division
State Corporation Commission
211 No. Broadway
Wichita, Kansas

Lane _____ County. Sec. 16 Twp. 17 Rge. _____ (E) 29 (W)

Location as "NE/CNW $\frac{1}{2}$ SW $\frac{1}{2}$ " or footage from lines NE SE
Lease Owner Sun Oil Company
Lease Name S. Boomhower Well No. 1
Office Address Box 1348, Tulsa, Oklahoma
Character of Well (completed as Oil, Gas or Dry Hole) Dryhole
Date well completed _____ 4-20- 1963
Application for plugging filed _____ 4-20- 1963
Application for plugging approved _____ 4-20- 1963
Plugging commenced _____ 4-20- 1963
Plugging completed _____ 4-21- 1963
Reason for abandonment of well or producing formation No oil or gas shows

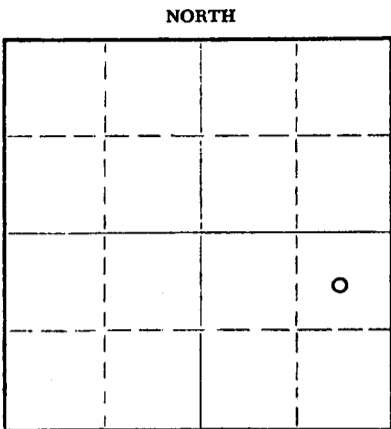

Locate well correctly on above Section Plat

If a producing well is abandoned, date of last production _____ 19____
Was permission obtained from the Conservation Division or its agents before plugging was commenced? Yes

Name of Conservation Agent who supervised plugging of this well W. L. Nichols, Moreland, Kansas
Producing formation None Depth to top _____ Bottom _____ Total Depth of Well 4712 Feet
Show depth and thickness of all water, oil and gas formations.

OIL, GAS OR WATER RECORDS

CASING RECORD

FORMATION	CONTENT	FROM	TO	SIZE	PUT IN	PULLED OUT
None				8-5/8"	265'	None

Describe in detail the manner in which the well was plugged, indicating where the mud fluid was placed and the method or methods used in introducing it into the hole. If cement or other plugs were used, state the character of same and depth placed, from _____ feet to _____ feet for each plug set.

Hole full 10.1# mud. Spotted 20 sack cement plug at 600'.
Spotted 20 sax cement plug at 250'
Spotted 10 sack cement plug 0-40'
Welded steel cap on top of casing.

RECEIVED
STATE CORPORATION COMMISSION
APR 25 1963
04-25-1963
CONSERVATION DIVISION
Wichita, Kansas

(If additional description is necessary, use BACK of this sheet)

Name of Plugging Contractor Gabbert-Jones, Inc.
Address 514 Orpheum Bldg., Wichita, Kansas

STATE OF OKLAHOMA COUNTY OF TULSA, ss.
J. H. Allen (employee of owner) or (~~owner or operator~~) of the above-described

well, being first duly sworn on oath, says: That I have knowledge of the facts, statements, and matters herein contained and the log of the above-described well as filed and that the same are true and correct. So help me God.

(Signature) J. H. Allen
Box 1348, Tulsa, Oklahoma
(Address)

SUBSCRIBED AND SWORN TO before me this 23rd day of April, 1963

My commission expires June 28, 1964 W. J. Goodner Notary Public.



WELL LOG
 SUN OIL COMPANY
 S. Boomhower No. 1
 NE/4 SE/4
 Sec. 16, Twp. 17S, Rge. 29W
 Lane County, Kansas

15101-19034-0000

<u>Formation</u>	<u>From</u>	<u>To</u>	Drilling Commenced 4-8-63
			Drilling Completed 4-20-63
Surface clay, sand and shale	0	275	Casing Record:
Lime, sand, shale	275	1175	
Shale w/l.s. strks.	1175	2560	8-5/8" at 265' w/200 sax cement.
Lime and shale	2560	3421	
Shale, sand, lime	3421	3694	
Lime and shale	3694	4525	Electric Log Tops:
Shale and sand	4525	4585	
Lime	4585	4712	Pennsylvania 3421'
		T.D.	Topeka 3694'
Dry and Abandoned.			Heebner 3931'
			Lansing-Kansas City 3972'
			Marmaton 4322'
			Cherokee 4525'
			Mississippi 4585'

I hereby certify that the foregoing is a true and correct copy of S. Boomhower No. 1 well log as recorded on the books of Sun Oil Company, Tulsa, Oklahoma

J.H. Allen

 J.H. Allen, Asst. Prod. Supt.

STATE OF OKLAHOMA)
 COUNTY OF TULSA) SS

Subscribed and sworn to before me this 23rd day of April, 1963

W.F. Goodner

 Notary Public

My Commission Expires:

_____ JUN 28 1964 _____

RECEIVED
 STATE CORPORATION COMMISSION
 APR 25 1963
 04-25-1963
 CONSERVATION DIVISION
 Wichita, Kansas