

9

STATE OF KANSAS STATE CORPORATION COMMISSION


Give All Information Completely Make Required Affidavit Mail or Deliver Report to: Conservation Division State Corporation Commission 212 No. Market Wichita, Kansas

WELL PLUGGING RECORD

RUSH County. Sec. 27 Twp. 19S Rge. 20 (E) W (W)

Location as "NE/CNWKSWK" or footage from lines. C NE SW Lease Owner: C-G DRILLING & GEORGE A REED Lease Name: HUDDLESTON #1 Office Address: 1107 UNION NATIONAL BLDG. Character of Well (completed as Oil, Gas or Dry Hole): DRY HOLE Date well completed: DEC 4, 1969 Application for plugging filed: DEC 4, 1969 Application for plugging approved: DEC 4, 1969 Plugging commenced: DEC 4, 1969 Plugging completed: DEC 4, 1969 Reason for abandonment of well or producing formation: TOO LOW STRUCTURALLY

NORTH

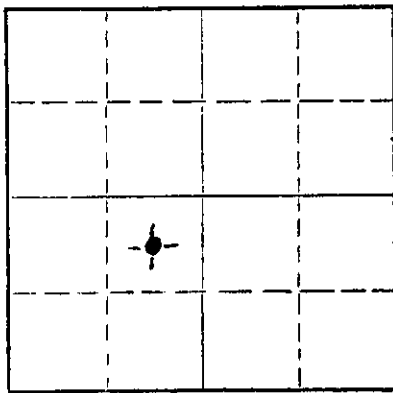

Locate well correctly on above Section Plat

If a producing well is abandoned, date of last production: 19 Was permission obtained from the Conservation Division or its agents before plugging was commenced? YES

Name of Conservation Agent who supervised plugging of this well: LEO F MASSEY, HAYS, KANSAS Producing formation: Depth to top: Bottom: Total Depth of Well: 4428' Feet Show depth and thickness of all water, oil and gas formations.

OIL, GAS OR WATER RECORDS

CASING RECORD

Table with 7 columns: FORMATION, CONTENT, FROM, TO, SIZE, PUT IN, PULLED OUT. Row 1: 8-5/8", 349.67', NONE

Describe in detail the manner in which the well was plugged, indicating where the mud fluid was placed and the method or methods used in introducing it into the hole. If cement or other plugs were used, state the character of same and depth placed, from feet to feet for each plug set.

FILLED WITH HEAVY MUD TO 660'. SET PLUG. PUT IN 70 SACKS CEMENT. FILLED WITH HEAVY MUD TO 330'. SET PLUG. PUT IN 20 SACKS CEMENT. FILLED WITH HEAVY MUD UP TO 40'. SET PLUG. FILLED TO TOP WITH 1 SACK HULLS AND 10 SACKS CEMENT.


RECEIVED STATE CORPORATION COMMISSION 12-24-69 DEC 24 1969 CONSERVATION DIVISION Wichita, Kansas

Name of Plugging Contractor: C=G DRILLING CO Address: 1107 UNION NATIONAL BLDG., WICHITA, KANSAS 67202

STATE OF KANSAS COUNTY OF SEDGWICK ss. G F GALLOWAY (employee of owner) or (owner or operator) of the above-described well, being first duly sworn on oath, says: That I have knowledge of the facts, statements, and matters herein contained and the log of the above-described well as filed and that the same are true and correct. So help me God.

(Signature) G F GALLOWAY 1107 UNION NATIONAL BLDG. (Address)

Subscribed and sworn to before me this 10th day of DECEMBER, 1969

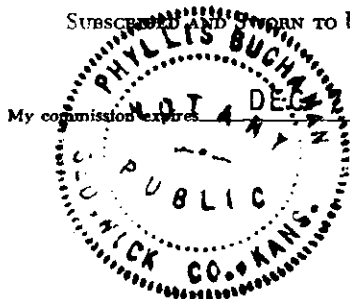

Phyllis Buchanan Notary Public

WELL LOG

OPERATOR: C-G DRILLING CO. & GEORGE A REED
 WELL NAME: HUDDLESTON #1 LOCATION: C NE SW
 COUNTY: RUSH STATE: KANSAS
 WELL COMMENCED: NOV. 26, 1969 WELL COMPLETED: DEC 4, 1969
 ELEVATION: 2267 KB TOTAL DEPTH: 4428'
 PRODUCTION: DRY & ABANDONED RIG NO: 1
 CASING - 8-5/8": 8 jts 349.67' w/180 SACKS CEMENT 2% GEL 2% CA CL
 5-1/2": _____

ALL MEASUREMENTS TAKEN FROM THE TOP OF ROTARY BUSHING:

| FROM | TO | FORMATION | DEVIATION FROM VERTICAL | REMARKS: |
|------|------|---------------|-------------------------|----------|
| 0 | 880 | SHALE | 3/4° | 1100' |
| 880 | 1080 | SAND | 3/4° | 1950' |
| 1080 | 1459 | RED BED | 1-1/4° | 2515' |
| 1459 | 1495 | ANHYDRITE | 1° | 3050' |
| 1495 | 1590 | SHALE & SHELL | | |
| 1590 | 1980 | SHALE & SAND | | |
| 1980 | 3780 | LIME & SHALE | | |
| 3780 | 4289 | LIME | | |
| 4389 | 4351 | LIME & SHALE | | |
| 4351 | 4410 | LIME | | |

RECEIVED
 STATE CORPORATION COMMISSION
 12-24-69
 DEC 24 1969
 CONSERVATION DIVISION
 Wichita, Kansas

STATE OF KANSAS)
 COUNTY OF SEDGWICK) SS:

The undersigned hereby certifies that to the best of his knowledge and belief, the above facts are true and correct.

C-G DRILLING CO.

By G F Galloway
 G F GALLOWAY

SUBSCRIBED AND SWORN TO, BEFORE ME, This 10th day of DECEMBER, 1969.

Phyllis Buchanan
 PHYLLIS BUCHANAN - NOTARY PUBLIC

