

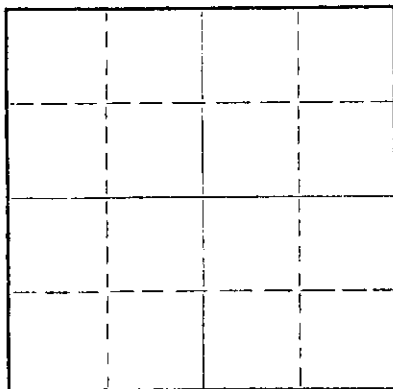
STATE OF KANSAS
STATE CORPORATION COMMISSION

Form CP-4

Give All Information Completely
Make Required Affidavit
Mail or Deliver Report to:
Conservation Division
State Corporation Commission
211 No. Broadway
Wichita, Kansas

WELL PLUGGING RECORD

NORTH

Locate well correctly on above
Section PlatRush County. Sec. 1 Twp. 19 Rge. 20W (E) (W)

Location as "NE/CNW/SW" or footage from lines C SW NE
Lease Owner DONALD C. SLAWSON
Lease Name Thalheim 'A' Well No. 1
Office Address 408 One Twenty Building - Wichita, Kansas 67202
Character of Well (completed as Oil, Gas or Dry Hole) Dry Hole
Date well completed August 31, 1966
Application for plugging filed " 31, 1966
Application for plugging approved " 31, 1966
Plugging commenced " 31, 1966
Plugging completed " 31, 1966
Reason for abandonment of well or producing formation Dry Hole
If a producing well is abandoned, date of last production 19
Was permission obtained from the Conservation Division or its agents before plugging was commenced? Yes

Name of Conservation Agent who supervised plugging of this well _____
Producing formation _____ Depth to top _____ Bottom _____ Total Depth of Well 4105 Feet
Show depth and thickness of all water, oil and gas formations.

OIL, GAS OR WATER RECORDS

CASING RECORD

FORMATION	CONTENT	FROM	TO	SIZE	PUT IN	PULLED OUT

Describe in detail the manner in which the well was plugged, indicating where the mud fluid was placed and the method or methods used in introducing it into the hole. If cement or other plugs were used, state the character of same and depth placed, from _____ feet to _____ feet for each plug set.

Mud to 480'; set plug; 30 sx cement
Mud to 290'; set plug; 20 sx cement
Bridge Kelly; 10 sx cement
2 sx cement in rat hole.

RECEIVED
STATE CORPORATION COMMISSION

SEP 7 1966

9-7-66

CONSERVATION DIVISION
Wichita, Kansas

(If additional description is necessary, use BACK of this sheet)

Name of Plugging Contractor Slawson Drilling Company, Inc.
Address 408 One Twenty Building - Wichita, Kansas 67202

STATE OF KANSAS, COUNTY OF SEDGWICK, ss.
DONALD C. SLAWSON (employee of owner) or (owner or operator) of the above-described well, being first duly sworn on oath, says: That I have knowledge of the facts, statements, and matters herein contained and the log of the above-described well as filed and that the same are true and correct. So help me God.

(Signature)

408 One Twenty Building-Wichita, Kansas
(Address)SUBSCRIBED AND SWORN TO before me this 6th day of September, 19 66My commission expires August 25, 1968Ella Priess
Ella Priess

Notary Public.

WELL LOG

Company: Donald C. Slawson
408 One Twenty Building
Wichita, Kansas 67202

Farm: Thalheim 'A' #1
C SW NE of Section 1-19S-20W
Rush County, Kansas

Total Depth: 4105' Elevation: 2116 K.B.

Commenced August 22, 1966

Completed: August 31, 1966

Contractor: Slawson Drilling Company, Inc.

Casing: 8 5/8" @ 290' with 225 sx cement

0-290	Clay, Sand, Shells
290-540	Sand & Shale
540-1305	Red Bed & Shale
1305-1335	Anhydrite
1335-1775	Shale & Shells
1775-2055	Shale & Lime
2055-2157	Lime & Shale
2157-2210	Shale & Lime
2210-3603	Lime & Shale
3603-4024	Lime
4024-4030	Lime & Shale
4030-4076	Sand
4076-4087	Conglomerate
4087-4105	Dolomite
4105	Total Depth

RECEIVED
STATE CORPORATION COMMISSION

SEP 7 1966
9-7-66
CONSERVATION DIVISION
Wichita, Kansas

STATE OF KANSAS)
) SS:
COUNTY OF SEDGWICK)

I, Donald C. Slawson, of the Slawson Drilling Company, Inc., upon oath state that the above and foregoing is a true and correct copy of the log of the Thalheim 'A' #1 well.


DONALD C. SLAWSON

Subscribed and sworn to before me this 6th day of September, 1966.


Ella Priess, Notary Public

My Commission Expires:
August 25, 1968