


STATE OF KANSAS
STATE CORPORATION COMMISSION

WELL PLUGGING RECORD

Give All Information Completely
Make Required Affidavit
Mail or Deliver Report to
Conservation Division
State Corporation Comm.
245 North Water
Wichita, KS 67202

Rush County. Sec. 2 Twp. 19S Rge. 20 ~~XX~~
Location as "NE/CNW $\frac{1}{4}$ /SW $\frac{1}{4}$ " or footage from lines _____
NW NW SE

Lease Owner Herbert G. Davis, Inc.
Lease Name Bott Well No. #1-2
Office Address 3030 Liberty Tower, Okla. City, Okla. 73102
Character of Well (Completed as Oil, Gas or Dry Hole) _____
Dry Hole

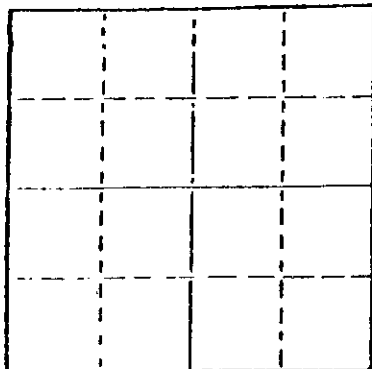

Locate well correctly on above
Section Plat

Date Well completed 3-11-80 19
Application for plugging filed 3-10-80 19
Application for plugging approved 3-10-80 19
Plugging commenced 3-10-80 19
Plugging completed 3-11-80 19
Reason for abandonment of well or producing formation _____
Commercial quantities of oil not found
If a producing well is abandoned, date of last production _____ 19

Was permission obtained from the Conservation Division or
its agents before plugging was commenced? Yes

Name of Conservation Agent who supervised plugging of this well Marion Schmidt
Producing formation _____ Depth to top _____ Bottom _____ Total Depth of Well 4320'
Show depth and thickness of all water, oil and gas formations.

OIL, GAS OR WATER RECORDS

CASING RECORD

FORMATION	CONTENT	FROM	TO	SIZE	PUT IN	PULLED OUT
				8 5/8"	607'	None

Describe in detail the manner in which the well was plugged, indicating where the mud fluid
was placed and the method or methods used in introducing it into the hold. If cement or other
plugs were used, state the character of same and depth placed, from _____ feet to
_____ feet for each plug set.

Plug @ 600' w/50 sx.
Plug @ 300' w/25 sx.
Plug @ 40' w/10 sx.
Rat Hole 5 sx.

RECEIVED
APR 14 1980
4-14-80

(If additional description is necessary, use BACK of this sheet.)

Name of Plugging Contractor Rains & Williamson Oil Co., Inc.

STATE OF Kansas COUNTY OF Sedgwick, ss.
Wilson Rains, President of Rains & Williamson Oil Co., Inc. (employee of owner) or (owner or operator)
of the above-described well, being first duly sworn on oath, says: That I have knowledge of
the facts, statements, and matters herein contained and the log of the above-described well
as filed and that the same are true and correct. So help me God.

(Signature) Wilson Rains
435 Page Court, 220 W. Douglas, Wichita, Kansas 67202
(Address)

18 day of March, 19 80



Sherry Herrell Notary Public.

DRILLER'S LOG

COMPANY: Herbert G. Davis, Inc.

SEC. 2 T. 19S R. 20W

WELL NAME: Bott #1-2

LOC. NW NW SE

COUNTY: Rush

RIG NO. #8

TOTAL DEPTH 4320'

ELEVATION

COMMENCED: 3-2-80

COMPLETED: 3-11-80

CONTRACTOR: Rains & Williamson Oil Co., Inc.

CASING RECORD:

SURFACE: 8 5/8" @ 607' w/330 sx. common, 2% gel, 3% cc.

PRODUCTION: D&A

LOG

(Figures Indicate Bottom of Formations)

Clay & Sand	50
Shale	608
Redbed, Sand, Shale & Shells	1130
Shale	1402
Redbed & Shale	1730
Shale	2119
Lime & Shale	2295
Shale & Lime	2675
Lime & Shale	2865
Shale & Lime	3070
Lime & Shale	3780
Shale & Lime	3920
Lime & Shale	4102
Shale & Lime	4187
Lime	4320
<u>ROTARY TOTAL DEPTH</u>	<u>4320</u>

RECEIVED
 STATE OF KANSAS
 APR 14 1980
 4-14-80

STATE OF Kansas)
 COUNTY OF Sedgwick) SS:

I, Wilson Rains, President of Rains & Williamson Oil Co., Inc.
 upon oath state that the above and foregoing is a true and correct copy of the log of the
Bott #1-2 well.

Wilson Rains
 Wilson Rains



Subscribed and sworn to before me this 18 day of March, 1980.

My Appointment Expires:
1-5-82

Sherry Herrell
 Sherry Herrell