

NOTICE OF INTENTION TO DRILL

(see rules on reverse side)

DA

Expected Spud Date... August 26, 1988 month day year

API Number 15-165-21,432-0000

OPERATOR: License # 3773 Name CASTLE-ROCK PRODUCTION, INC. Address 8100 E. 22nd N. Bldg. 300, Suite 400 City/State/Zip Wichita, Kansas 67226 Contact Person Scott Oatsdean Phone 316/687-9414

S/2. SE.. NE.. Sec.. 10 Twp.. 19 S, Rg.. 20 X West 2970 Ft. from South Line of Section 660 Ft. from East Line of Section

(Note: Locate well on Section Plat on reverse side)

CONTRACTOR: License # 5864 Name LOBO DRILLING COMPANY City/State Great Bend, Kansas 67530

Nearest lease or unit boundary line 330 feet County Rush Lease Name Miller "A" Well # #1

Well Drilled For: X Oil Storage X Infield X Mud Rotary Gas Inj Pool Ext Air Rotary OWWO Expl Wildcat Cable

Ground surface elevation 2169 feet MSL Domestic well within 330 feet: yes X no Municipal well within one mile: yes X no Depth to bottom of fresh water 400 600 Depth to bottom of usable water Surface pipe by Alternate: 1 2 X

If OWWO: old well info as follows:

Surface pipe planned to be set 240+ Conductor pipe required Projected Total Depth 4300 feet Formation Mississippian

Operator Well Name Comp Date Old Total Depth

I certify that well will comply with K.S.A. 55-101, et seq, plus eventually plugging hole to KCC specifications.

Date August 24, 1988 Signature of Operator or Agent Sally R. Byers Title Agent

For KCC Use:

Conductor Pipe Required feet; Minimum Surface Pipe Required 200 feet per Alt. X 2 This Authorization Expires 2-24-89 Approved By LKM 8-24-88


EFFECTIVE DATE: 8-29-88

Must be filed with the K.C.C. five (5) days prior to commencing well  
This card void if drilling not started within six (6) months of date received by K.C.C.

**Important procedures to follow:**

1. Notify District office before setting surface casing.
2. Set surface casing by circulating cement to the top.
3. File completion forms ACO-1 with K.C.C. within 120 days of well spud date, following instructions on ACO-1, side 1, and including copies of wireline logs.
4. Notify District office 48 hours prior to old well workover or re-entry.
5. Prior to filing Intent, prepare a proposed plugging plan in case well is D & A, then obtain approval of plan when calling district office prior to setting surface pipe.
6. Submit plugging report (CP-4) to K.C.C. after plugging is completed.
7. Obtain an approved injection docket number before disposing of salt water.
8. Notify K.C.C. within 10 days when injection commences or terminates.
9. If an alternate 2 completion, cement in the production pipe from below any usable water to surface within 120 days of spud date.

**A Regular Section of Land  
1 Mile = 5,280 Ft.**

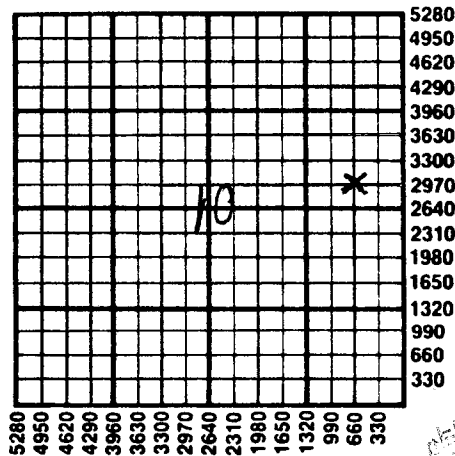

RECEIVED  
STATE CORPORATION COMMISSION  
AUG 24 1988  
8-24-88

CONSERVATION DIVISION  
Wichita, Kansas

State Corporation Commission of Kansas  
Conservation Division  
200 Colorado Derby Building  
Wichita, Kansas 67202-1212  
(316) 263-3238