

CARD MUST BE TYPED

# State of Kansas NOTICE OF INTENTION TO DRILL

CARD MUST BE SIGNED

(see rules on reverse side)

Starting Date: 12-19-85  
month day year

API Number 15- 165-21,342-0000

OPERATOR: License # 5652  
Name Mustang Drilling & Exploration, Inc.  
Address P. O. Box 1609  
City/State/Zip Great Bend, KS 67530  
Contact Person Jim Meroney  
Phone 316-792-7323

NW, NW (location) Sec 32 Twp 19 S, Rge 19  East  West

4620 Ft North from Southeast Corner of Section  
4620 Ft West from Southeast Corner of Section  
(Note: Locate well on Section Plat on reverse side)

CONTRACTOR: License # 5652  
Name Mustang Drilling & Exploration, Inc.  
City/State Great Bend, Kansas 67530

Nearest lease or unit boundary line 660 feet.  
County Rush  
Lease Name Maresch Well# 1-32

Well Drilled For:  Oil  Swd  Infield  Gas  Inj  Pool Ext.  OWWO  Expl  
Well Class:  Infield  Pool Ext.  Wildcat  
Type Equipment:  Mud Rotary  Air Rotary  Cable

Domestic well within 330 feet:  yes  no  
Municipal well within one mile:  yes  no

If OWWO: old well info as follows:  
Operator  
Well Name  
Comp Date Old Total Depth 4375  
Projected Total Depth feet  
Projected Formation at TD Mississippi  
Expected Producing Formations Cherokee Sand & Miss.

Depth to Bottom of fresh water Dakota 250 feet  
Lowest usable water formation ~~Choyenne~~ DAKOTA  
Depth to Bottom of usable water 330 480 feet  
Surface pipe by Alternate: 1  2   
Surface pipe to be set 400 480 feet  
Conductor pipe if any required none feet  
Ground surface elevation feet MSL  
This Authorization Expires 6-4-86

I certify that we will comply with K.S.A. 55-101, et seq., plus eventually plugging hole to K.C.C. specifications.

Date 12-3-85 Signature of Operator or Agent

Approved By [Signature] Title Exploration Manager  
12-4-85 [Signature] RET/POE

Must be filed with the K.C.C. five (5) days prior to commencing well  
This card void if drilling not started within six (6) months of date received by K.C.C.

RECEIVED  
STATE CORPORATION COMMISSION


DEC 04 1985

Important procedures to follow :

A Regular Section of Land  
1 Mile = 5,280 Ft.

CONSERVATION DIVISION  
Wichita, Kansas

1. Notify District office before setting surface casing.
2. Set surface casing by circulating cement to the top.
3. File completion forms ACO-1 with K.C.C. within 90 days of well completion, following instructions on ACO-1, side 1, and including copies of wireline logs.
4. Notify District office 48 hours prior to old well workover or re-entry.
5. Prior to plugging, prepare a plugging plan, then obtain agreement from the appropriate district office for an approved plugging plan.
6. Submit plugging report (CP-4) to K.C.C. after plugging is completed.
7. Obtain an approved injection docket number before disposing of salt water.
8. Notify K.C.C. within 10 days when injection commences or terminates.
9. If an alternate 2 completion, cement in the production pipe from below any usable water to surface within 120 days of spud date.

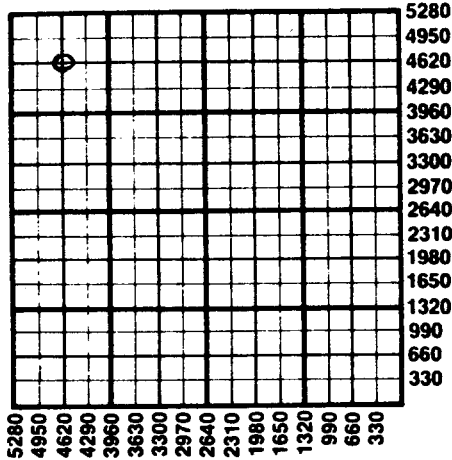

State Corporation Commission of Kansas  
Conservation Division  
200 Colorado Derby Building  
Wichita, Kansas 67202  
(316) 263-3238