

CARD MUST BE SIGNED

API Number 15- 165-21,303-0000

C . . . SE . . . NW Sec 24 Twp 19 S, Rge 20
(Location)

...3300..... Ft North from Southeast Corner of Section
 ...3300..... Ft West from Southeast Corner of Section
 (Note: Locate well on Section Plat on reverse side)

Nearest lease or unit boundary line 660 feet.

County Rush

Lease Name ..Schank..... Well# 1-24

Domestic well within 330 feet : ☐ yes ☒ no

Municipal well within one mile : ☐ yes ☒ no

Depth to Bottom of fresh water150..... feet

Lowest usable water formation Dakota.....

Depth to Bottom of usable water 400 feet

Surface pipe by Alternate : 1 ☒ 2 ☐

Surface pipe to be set 560 feet

Conductor pipe if any required none feet

Ground surface elevation **unknown** **feet MSI.**

This Authorization Expires 12-25-85 *D*

Approved By 6-25-85 [Signature]

I certify that we will comply with K.S.A. 55-101, et seq., plus eventually plugging hole to K.C.C. specifications.

6-24-85


Date Signature of Operator or Agent

ACN for KONE
Production Engineer

Must be filed with the K.C.C. five (5) days prior to commencing well
This card void if drilling not started within six (6) months of date received by K.C.C.

RECEIVED
STATE CORPORATION COMMISSION
JUN 25 1985
6-25-85

A Regular Section of Land
1 Mile = 5,280 Ft.

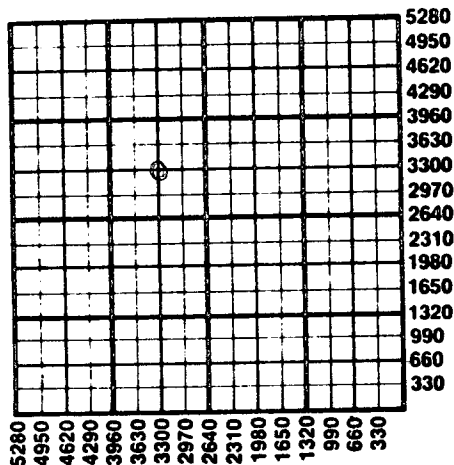

Important procedures to follow :

1. Notify District office before setting surface casing.
2. Set surface casing by circulating cement to the top.
3. File completion forms ACO-1 with K.C.C. within 90 days of well completion, following instructions on ACO-1, side 1, and including copies of wireline logs.
4. Notify District office 48 hours prior to old well workover or re-entry.
5. Prior to plugging, prepare a plugging plan, then obtain agreement from the appropriate district office for an approved plugging plan.
6. Submit plugging report (CP-4) to K.C.C. after plugging is completed.
7. Obtain an approved injection docket number before disposing of salt water.
8. Notify K.C.C. within 10 days when injection commences or terminates.
9. If an alternate 2 completion, cement in the production pipe from below any usable water to surface within 120 days of spud date.

State Corporation Commission of Kansas
Conservation Division
200 Colorado Derby Building
Wichita, Kansas 67202
(316) 263-3238