

CARD MUST BE TYPED

State of Kansas
NOTICE OF INTENTION TO DRILL

CARD MUST BE SIGNED

(see rules on reverse side)

Starting Date: 10 9 84
month day year

API Number 15- 165-21,260-0000

OPERATOR: License # 5190
Name Sabre Exploration, Inc.
Address 310 W. Central, #214
City/State/Zip Wichita, KS 67202
Contact Person Matt Totten
Phone 316 264-2635

SE NW NE Sec 1 Twp 19 S, Rge 20
(location) 4290
 East
 West

..... Ft North from Southeast Corner of Section
.1650..... Ft West from Southeast Corner of Section
(Note: Locate well on Section Plat on reverse side)

CONTRACTOR: License #
Name Republic Drilling, Inc.
City/State Pratt, KS 67454

Nearest lease or unit boundary line 990 feet.
County Rush
Lease Name Saltman Well# 1

Well Drilled For: Well Class: Type Equipment:
 Oil Swd Infield Mud Rotary
 Gas Inj Pool Ext. Air Rotary
 OWWO Expl Wildcat Cable

Domestic well within 330 feet: yes no
Municipal well within one mile: yes no

If OWWO: old well info as follows:

Operator
Well Name
Comp Date Old Total Depth
Projected Total Depth 4100 feet
Projected Formation at TD Cherokee
Expected Producing Formations Cherokee

Depth to Bottom of fresh water 100 feet
Lowest usable water formation Dakota
Depth to Bottom of usable water 500 feet
Surface pipe by Alternate: 1 2
Surface pipe to be set 300 feet
Conductor pipe if any required feet
Ground surface elevation 2130 feet MSL
This Authorization Expires 4-5-85
Approved By 10-5-84

I certify that we will comply with K.S.A. 55-101, et seq., plus eventually plugging hole to K.C.C. specifications.

Date 10-5-84 Signature of Operator or Agent Matt W. Totten Title President

MHC/NOHE 10/5/84


Must be filed with the K.C.C. five (5) days prior to commencing well
This card void if drilling not started within six (6) months of date received by K.C.C.

WICHITA, KANSAS

10-5-84
OCT 5 1984

STATE CORPORATION COMMISSION

Regular Section of Land
1 Mile 3,280 Ft.

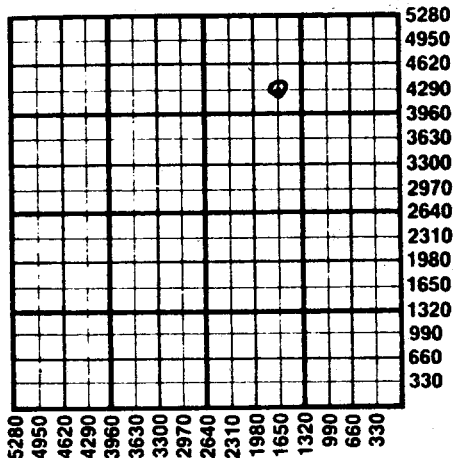

Important procedures to follow :

1. Notify District office before setting surface casing.
2. Set surface casing by circulating cement to the top.
3. File completion forms ACO-1 with K.C.C. within 90 days of well completion, following instructions on ACO-1, side 1, and including copies of wireline logs.
4. Notify District office 48 hours prior to old well workover or re-entry.
5. Prior to plugging, prepare a plugging plan, then obtain agreement from the appropriate district office for an approved plugging plan.
6. Submit plugging report (CP-4) to K.C.C. after plugging is completed.
7. Obtain an approved injection docket number before disposing of salt water.
8. Notify K.C.C. within 10 days when injection commences or terminates.
9. If an alternate 2 completion, cement in the production pipe from below any usable water to surface within 120 days of spud date.

State Corporation Commission of Kansas
Conservation Division
200 Colorado Derby Building
Wichita, Kansas 67202
(316) 263-3238