

CARD MUST BE TYPED

NOTICE OF INTENTION TO DRILL

CARD MUST BE SIGNED

(see rules on reverse side)

Starting Date: May 10, 1985 month day year

API Number 15- 077-21, 091-00-00

OPERATOR: License # 5004 Name Vincent Oil Corporation Address 125 N. Market #1110 City/State/Zip Wichita, Ks, 67202 Contact Person Ruth Benjamin Phone 316-262-3573

C. W 1/2 SE 1/4 SE 1/4 Sec 8 Twp 31 S. Rge 9 East West

660 Ft North from Southeast Corner of Section 990 Ft West from Southeast Corner of Section (Note: Locate well on Section Plat on reverse side)

CONTRACTOR: License # 5149 Name Wheatstate Oilfield Services, Inc. City/State Pratt, Ks, 67124

Nearest lease or unit boundary line 660 feet. County Harper Lease Name Davis Well# 1

Well Drilled For: Well Class: Type Equipment: Oil Swd Infield Mud Rotary Gas Inj Pool Ext Air Rotary OWWO Expl Wildcat Cable

Domestic well within 330 feet: yes no Municipal well within one mile: yes no

If OWWO: old well info as follows: Operator Well Name Comp Date Old Total Depth Projected Total Depth 3650 Projected Formation at TD Toronto Expected Producing Formations

Depth to Bottom of fresh water 80 feet Lowest usable water formation Depth to Bottom of usable water 200 feet Surface pipe by Alternate: 1 2 Surface pipe to be set 280 feet Conductor pipe if any required n/a feet Ground surface elevation applied for feet MSL This Authorization Expires 11-7-95 Approved By 5-7-85

I certify that we will comply with K.S.A. 55-101, et seq., plus eventually plugging hole to K.C.C. specifications.

Date May 7, 1985 Signature of Operator or Agent Richard A. Hiebsch Title Vice President

Richard A. Hiebsch


RECEIVED

Must be filed with the K.C.C. five (5) days prior to commencing well
This card void if drilling not started within six (6) months of date received by K.C.C.

STATE CORPORATION COMMISSION

MAY 7 1985

CONSERVATION DIVISION
A Regular Section of Land
1 Mile - 5,280 Ft.
Wichita, Kansas

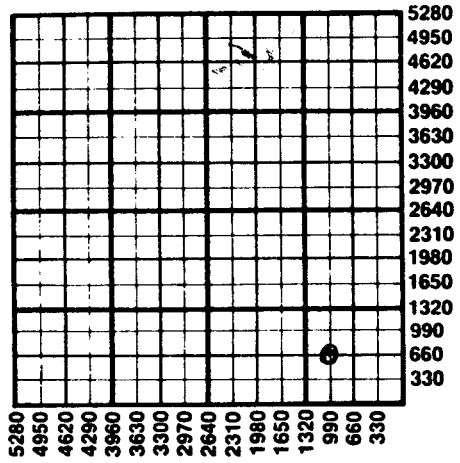

Important procedures to follow:

1. Notify District office before setting surface casing.
2. Set surface casing by circulating cement to the top.
3. File completion forms ACO-1 with K.C.C. within 90 days of well completion, following instructions on ACO-1, side 1, and including copies of wireline logs.
4. Notify District office 48 hours prior to old well workover or re-entry.
5. Prior to plugging, prepare a plugging plan, then obtain agreement from the appropriate district office for an approved plugging plan.
6. Submit plugging report (CP-4) to K.C.C. after plugging is completed.
7. Obtain an approved injection docket number before disposing of salt water.
8. Notify K.C.C. within 10 days when injection commences or terminates.
9. If an alternate 2 completion, cement in the production pipe from below any usable water to surface within 120 days of spud date.

State Corporation Commission of Kansas
 Conservation Division
 200 Colorado Derby Building
 Wichita, Kansas 67202
 (316) 263-3238