

CARD MUST BE TYPED

State of Kansas  
**NOTICE OF INTENTION TO DRILL**  
(see rules on reverse side)

CARD MUST BE SIGNED

Starting Date: ..... March 25 1985  
month day year

API Number 15- 165-21,292-0000

OPERATOR: License # 5027  
Name J. A. Allison  
Address 300 West Douglas, Suite 305  
City/State/Zip Wichita, Kansas 67202  
Contact Person J. A. Allison  
Phone 316-263-2241

C N2 N2 NE Sec 16 Twp 18 S, Rge 18  East  
(location)  West  
4950 Ft North from Southeast Corner of Section  
1320 Ft West from Southeast Corner of Section  
(Note: Locate well on Section Plat on reverse side)

CONTRACTOR: License # 5122  
Name Woodman-Iannitti Drilling Co.  
City/State 1022 Union Center, Wichita, Ks. 67202

Nearest lease or unit boundary line ..... 330 feet.  
County ..... RUSH  
Lease Name DIRKS Well# 2  
Domestic well within 330 feet :  yes  no  
Municipal well within one mile :  yes  no

Well Drilled For: Well Class: Type Equipment:  
 Oil  Swd  Infield  Mud Rotary  
 Gas  Inj  Pool Ext.  Air Rotary  
 OWWO  Expl  Wildcat  Cable

Depth to Bottom of fresh water ..... 250 feet  
Lowest usable water formation ..... Dakota  
Depth to Bottom of usable water ..... 550 feet  
Surface pipe by Alternate : 1  2   
Surface pipe to be set ..... 1200 feet  
Conductor pipe if any required ..... None feet  
Ground surface elevation ..... 2090 feet MSL  
This Authorization Expires 9-7-85  
Approved By 3-7-85 [Signature]

If OWWO: old well info as follows:

Operator .....  
Well Name .....  
Comp Date ..... Old Total Depth .....  
Projected Total Depth ..... 3820 feet  
Projected Formation at TD ..... Arbuckle  
Expected Producing Formations ..... Arbuckle

I certify that we will comply with K.S.A. 55-101, et seq., plus eventually plugging here to K.C.C. specifications.

Date March 6, 1985 Signature of Operator or Agent [Signature] Title J. A. Allison


Operator [Signature]  
Form C-1 4/84

MHC/WOHE 3-8-85

Must be filed with the K.C.C. five (5) days prior to commencing well  
This card void if drilling not started within six (6) months of date received by K.C.C.

**Important procedures to follow :**

**A Regular Section of Land  
1 Mile = 5,280 Ft.**

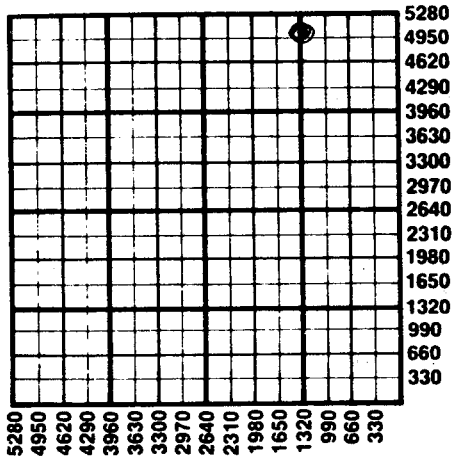

1. Notify District office before setting surface casing.
2. Set surface casing by circulating cement to the top.
3. File completion forms ACO-1 with K.C.C. within 90 days of well completion, following instructions on ACO-1, side 1, and including copies of wireline logs.
4. Notify District office 48 hours prior to old well workover or re-entry.
5. Prior to plugging, prepare a plugging plan, then obtain agreement from the appropriate district office for an approved plugging plan.
6. Submit plugging report (CP-4) to K.C.C. after plugging is completed.
7. Obtain an approved injection docket number before disposing of salt water.
8. Notify K.C.C. within 10 days when injection commences or terminates.
9. If an alternate 2 completion, cement in the production pipe from below any usable water to surface within 120 days of spud date.

RECEIVED  
STATE CORPORATION COMMISSION

MAR 07 1985

3-7-85  
CONSERVATION DIVISION  
Wichita, Kansas

State Corporation Commission of Kansas  
Conservation Division  
200 Colorado Derby Building  
Wichita, Kansas 67202  
(316) 263-3238