

CARD MUST BE TYPED

State of Kansas

CARD MUST BE SIGNED

NOTICE OF INTENTION TO DRILL

Expected Spud Date: August 5 1988
month day year

(see rules on reverse side)

API Number 15-165-21,429-0000

OPERATOR: License # 5027
Name J. A. Allison
Address 300 West Douglas, Suite 305
City/State/Zip Wichita, Kansas 67202
Contact Person J. A. Allison
Phone (316) 263-2241

CONTRACTOR: License # 5122
Name Woodman-Iannitti Drilling Co.
City/State Box 308, Great Bend, KS 67530

Well Drilled For: Well Class: Type Equipment:
☒ Oil ☐ Storage ☐ Infield ☒ Mud Rotary
☐ Gas ☐ Inj ☐ Pool Ext. ☐ Air Rotary
☐ OWWO ☒ Expl ☒ Wildcat ☐ Cable

If OWWO: old well info as follows:

Operator
Well Name
Comp Date Old Total Depth

I certify that well will comply with K.S.A. 55-101, et seq., plus eventually plugging hole to KCC specifications.

Date July 28, 1988 Signature of Operator or Agent J. A. Allison Title Operator

For KCC Use:

Conductor Pipe Required feet; Minimum Surface Pipe Required 440 feet per Alt. (1) X
This Authorization Expires 1-29-89 Approved By LKM 7-29-88

EFFECTIVE DATE: 8-3-88

— East
NW.. NW NE Sec. 11.. Twp. 18.. S, Rg. 18.... X West
4950 Ft. from South Line of Section
2310 Ft. from East Line of Section

(Note: Locate well on Section Plat on reverse side)

Nearest lease or unit boundary line 330 feet

County RUSH

Lease Name PARSONS Well # 1

Ground surface elevation 2057 feet MSL

Domestic well within 330 feet: ☐ yes ☒ noMunicipal well within one mile: ☐ yes ☒ no

Depth to bottom of fresh water 270-340

Depth to bottom of usable water 440-400 Top Permian

Surface pipe by Alternate: 1 X 2

Surface pipe planned to be set 1200'

Conductor pipe required None

Projected Total Depth 3802 feet


Formation Arbuckle

Must be filed with the K.C.C. five (5) days prior to commencing well
This card void if drilling not started within six (6) months of date received by K.C.C.

Important procedures to follow:

1. Notify District office before setting surface casing.
2. Set surface casing by circulating cement to the top.
3. File completion forms ACO-1 with K.C.C. within 120 days of well spud date, following instructions on ACO-1, side 1, and including copies of wireline logs.
4. Notify District office 48 hours prior to old well workover or re-entry.
5. Prior to filing Intent, prepare a proposed plugging plan in case well is plugged. Then obtain approval of plan when calling district office prior to setting surface pipe.
6. Submit plugging report (CP-4) to K.C.C. after plugging is completed.
7. Obtain an approved injection docket number before disposing of salt water.
Notify K.C.C. within 10 days when injection commences or terminates.
9. If an alternate 2 completion, cement in the production pipe from below any usable water to surface within 120 days of spud date.

A Regular Section of Land
1 Mile = 5,280 Ft.

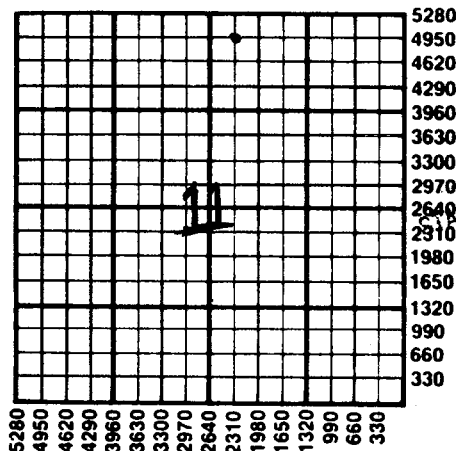

RECEIVED
STATE CORPORATION COMMISSION
JUL 29 1988
7-29-88
CONSERVATION DIVISION
Wichita, Kansas

State Corporation Commission of Kansas
Conservation Division
200 Colorado Derby Building
Wichita, Kansas 67202-1212
(316) 263-3238