

FOR KCC USE:

FORM C-1 7/91

EFFECTIVE DATE: 2-14-93

FORM MUST BE TYPED

DISTRICT # 1  
SGA? Yes  No

State of Kansas  
NOTICE OF INTENTION TO DRILL

FORM MUST BE SIGNED  
ALL BLANKS MUST BE FILLED

Must be approved by the K.C.C. five (5) days prior to commencing well

Expected Spud Date February 15 1993  
month day year

Spot NE SW Sec 34 Twp 20 S Rg 35 East  
SE West

OPERATOR: License # 5003  
Name: McCoy Petroleum Corporation  
Address: 110 S. Main, Suite 500  
City/State/Zip: Wichita, KS 67202  
Contact Person: Robert O'Dell  
Phone: (316) 265-9697

1650 feet from South / North line of Section  
2970 feet from East / West line of Section

IS SECTION  REGULAR  IRREGULAR  
(NOTE: Locate well on the Section Plat on Reverse Side)

County: Wichita  
Lease Name: Wilken "A" Well #: 1-34  
Field Name: White Woman

Is this a Prorated/Spaced Field? yes  no

Target Formation(s): Marmaton  
Nearest lease or unit boundary: 330'

Ground Surface Elevation: 3170 Est. feet MSL  
Water well within one-quarter mile: yes  no

Public water supply well within one mile: yes  no   
Depth to bottom of fresh water: 120'

Depth to bottom of usable water: 1170'  
Surface Pipe by Alternate: 1  2  400+-

Length of Surface Pipe Planned to be set: 5100'  
Length of Conductor pipe required: -0-

Projected Total Depth: 5100'  
Formation at Total Depth: Mississippian

Water Source for Drilling Operations:  
 well  farm pond  other

DWR Permit #: To Be Applied For  
Will Cores Be Taken? yes  no

If yes, proposed zone: \_\_\_\_\_  
If no, proposed zone: \_\_\_\_\_

CONTRACTOR: License #: 5658  
Name: Sweetman Drilling, Inc.

Well Drilled For: Well Class: Type Equipment:  
 Oil  Enh Rec  Infield  Mud Rotary  
 Gas  Storage  Pool Ext.  Air Rotary  
 OUVU  Disposal  Wildcat  Cable  
 Seismic;  # of Holes  Other

If OUVU: old well information as follows:  
Operator: \_\_\_\_\_  
Well Name: \_\_\_\_\_  
Comp. Date: \_\_\_\_\_ Old Total Depth \_\_\_\_\_

Directional, Deviated or Horizontal wellbore? yes  no   
If yes, true vertical depth: \_\_\_\_\_  
Bottom Hole Location: \_\_\_\_\_

AFFIDAVIT

The undersigned hereby affirms that the drilling, completion and eventual plugging of this well will comply with K.S.A. 55-101, et. seq.  
It is agreed that the following minimum requirements will be met:

1. Notify the appropriate district office prior to spudding of well;
2. A copy of the approved notice of intent to drill shall be posted on each drilling rig;
3. The minimum amount of surface pipe as specified below shall be set by circulating cement to the top; in all cases surface pipe shall be set through all unconsolidated materials plus a minimum of 20 feet into the underlying formation;
4. If the well is dry hole, an agreement between the operator and the district office on plug length and placement is necessary prior to plugging;
5. The appropriate district office will be notified before well is either plugged or production casing is cemented in;
6. IF AN ALTERNATE II COMPLETION, PRODUCTION PIPE SHALL BE CEMENTED FROM BELOW ANY USABLE WATER TO SURFACE WITHIN 120 DAYS OF SPUD DATE. IN ALL CASES, NOTIFY DISTRICT OFFICE PRIOR TO ANY CEMENTING.

I hereby certify that the statements made herein are true and to the best of my knowledge and belief.  
Date: 2-8-93 Signature of Operator or Agent: [Signature] Title: Geologist

FOR KCC USE:  
API # 15- 203-20098-0000  
Conductor pipe required None feet  
Minimum surface pipe required 200 feet per Alt.   
Approved by: [Signature] 2-9-93  
This authorization expires: 8-9-93  
(This authorization void if drilling not started within 6 months of effective date.)  
Spud date: \_\_\_\_\_ Agent: \_\_\_\_\_

RECEIVED  
KANSAS CORPORATION COMMISSION  
FEB 08 1993  
2-8-93  
CONSERVATION DIVISION  
WICHITA, KS

REMEMBER TO:

- File Drill Pit Application (form SDP-1) with Intent to Drill;
- File Completion Form ACO-1 within 120 days of spud date;
- File acreage attribution plat according to field prorator orders;
- Notify appropriate district office 48 hours prior to workover or re-entry;
- Submit plugging report (CP-4) after plugging is completed;
- Obtain written approval before disposing or injecting salt water.

Mail to: Conservation Division, 200 Colorado Derby Building, 202 W. First St., Wichita, Kansas 67202-1286.

34  
20  
35

IN ALL CASES PLOT THE INTENDED WELL ON THE PLAT BELOW  
PLAT OF ACREAGE ATTRIBUTABLE TO A WELL IN A PRORATED OR SPACED FIELD

If the intended well is in a prorated or spaced field, please fully complete this side of the form. If the intended well is in a prorated or spaced field complete the plat below showing that the well will be properly located in relationship to other wells producing from the common source of supply. Please show all the wells within 1 mile of the boundaries of the proposed acreage attribution unit for gas wells and within 1/2 mile of the boundaries of the proposed acreage attribution unit for oil wells.

API NO. 15- \_\_\_\_\_  
 OPERATOR McCoy Petroleum Corporation  
 LEASE Wilken "A"  
 WELL NUMBER 1-34  
 FIELD White Woman

LOCATION OF WELL: COUNTY Wichita  
1650 feet from south/north line of section  
2970 feet from east/west line of section  
 SECTION 34 TWP 20S RG 35W



NUMBER OF ACRES ATTRIBUTABLE TO WELL 40  
 QTR/QTR/QTR OF ACREAGE - NE - SW

IS SECTION X REGULAR or IRREGULAR  
IF SECTION IS IRREGULAR, LOCATE WELL FROM NEAREST CORNER BOUNDARY.

Section corner used: NE NW SE SW

**PLAT**

(Show location of the well and shade attributable acreage for prorated or spaced wells.)  
 (Show footage to the nearest lease or unit boundary line.)

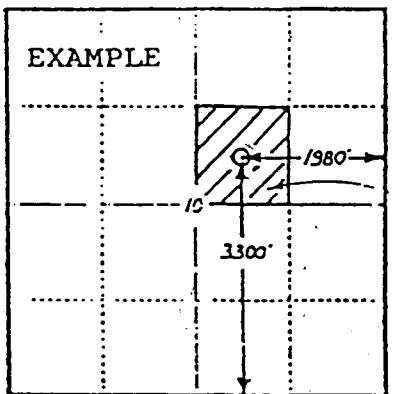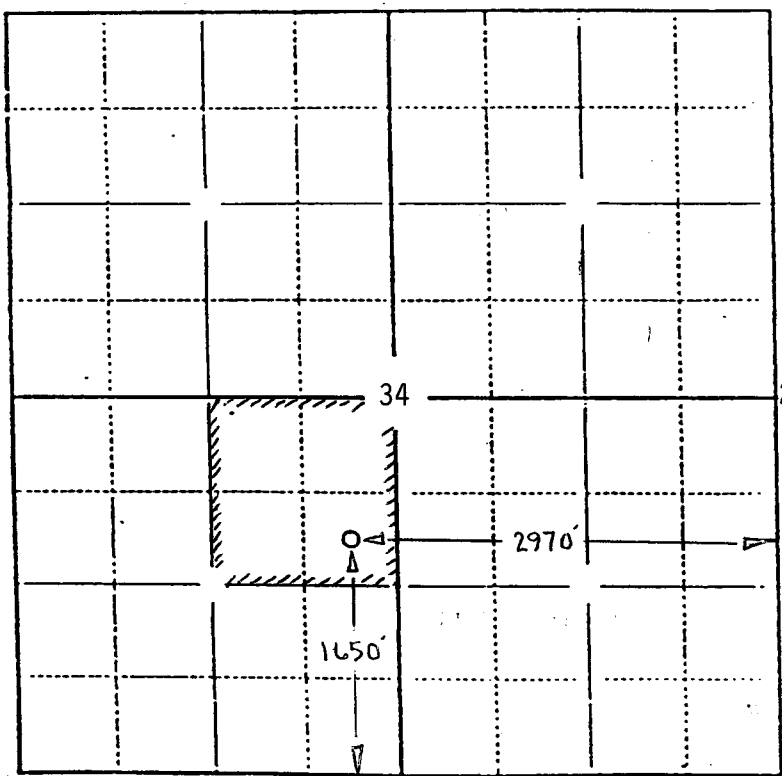

In plotting the proposed location of the well, you must show:

- 1) The manner in which you are using the depicted plat by identifying section lines, i.e. 1 section, 1 section with 8 surrounding sections, 4 sections, etc.;
- 2) the distance of the proposed drilling location from the section's south/north and east/west lines; and
- 3) the distance to the nearest lease or unit boundary line.