

CARD MUST BE TYPED

State of Kansas  
**NOTICE OF INTENTION TO DRILL**

CARD MUST BE SIGNED

(see rules on reverse side)

Starting Date: ..... 9 23 85  
month day year

API Number 15- 135-22,918-0000

OPERATOR: License # 5161

SE SW SW Sec 32 Twp 16 S, Rge 23  
(location)  East  West

Name Palomino Petroleum

Address P.O. Box 18610

City/State/Zip Wichita, KS 67218

Contact Person Bob Watchous

Phone (316) 683-8152

330 Ft North from Southeast Corner of Section

4290 Ft West from Southeast Corner of Section

(Note: Locate well on Section Plat on reverse side)

CONTRACTOR: License # 5476

Nearest lease or unit boundary line ..... 330 feet

Name DNB Drilling, Inc.

County Ness

City/State Wichita, KS 67208

Lease Name Mishler "L" Well# 2

Well Drilled For: Well Class: Type Equipment:

- Oil  Swd  Infield  Mud Rotary
- Gas  Inj  Pool Ext.  Air Rotary
- OWWO  Expl  Wildcat  Cable

Domestic well within 330 feet:  yes  no

Municipal well within one mile:  yes  no

If OWWO: old well info as follows:

Operator .....

Well Name .....

Comp Date ..... Old Total Depth .....

Projected Total Depth 4550 feet

Projected Formation at TD Miss.

Expected Producing Formations Marm., Chero. sd.

If run, production string will be cemented immediately to protect the Dakota.

Depth to Bottom of fresh water ..... 80 feet

Lowest usable water formation ..... Dakota

Depth to Bottom of usable water ..... 860 feet

Surface pipe by Alternate: 1  2

Surface pipe to be set ..... 230+ feet

Conductor pipe if any required ..... feet

Ground surface elevation ..... 2485 est. feet MSL

This Authorization Expires 3-6-86

Approved By 9-6-85 *RCH*

I certify that we will comply with K.S.A. 55-101, et seq., plus eventually plugging hole to K.C.C. specifications.


Date 9-4-85 Signature of Operator or Agent *Bob Watchous*

Title Owner *RCH for KOWE*

Must be filed with the K.C.C. five (5) days prior to commencing well  
 This card void if drilling not started within six (6) months of date received by K.C.C.

**Important procedures to follow:**

**A Regular Section of Land**  
**1 Mile = 5,280 Ft.**

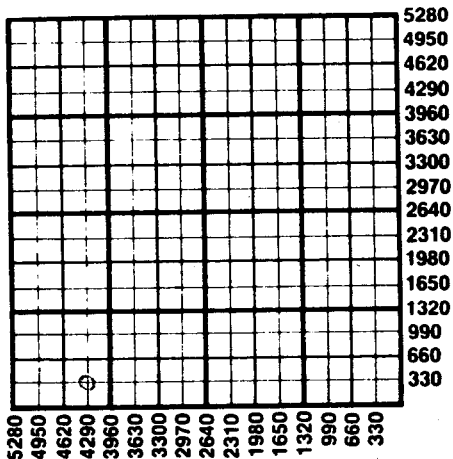

1. Notify District office before setting surface casing.
2. Set surface casing by circulating cement to the top.
3. File completion forms ACO-1 with K.C.C. within 90 days of well completion, following instructions on ACO-1, side 1, and including copies of wireline logs.
4. Notify District office 48 hours prior to old well workover or re-entry.
5. Prior to plugging, prepare a plugging plan, then obtain agreement from the appropriate district office for an approved plugging plan.
6. Submit plugging report (CP-4) to K.C.C. after plugging is completed.
7. Obtain an approved injection docket number before disposing of salt water.
8. Notify K.C.C. within 10 days when injection commences or terminates.
9. If an alternate 2 completion, cement in the production pipe from below any usable water to surface within 120 days of completion date.

State Corporation Commission of Kansas  
 Conservation Division  
 200 Colorado Derby Building  
 Wichita, Kansas 67202  
 (316) 263-3238

RECEIVED  
 STATE CORPORATION COMMISSION  
 SEP 6 1985  
 9-6-85  
 CONSERVATION DIVISION  
 Wichita, Kansas