

FOR KCC USE:

FORM C-1 7/91

FORM MUST BE TYPED

EFFECTIVE DATE: 5-27-95

State of Kansas

FORM MUST BE SIGNED

DISTRICT # 1

NOTICE OF INTENTION TO DRILL

ALL BLANKS MUST BE FILLED

SGA? Yes X No

Must be approved by the K.C.C. five (5) days prior to commencing well.

Expected Spud Date 6/05/95  
month day year

Spot East  
NE NE NE Sec .30.. Twp .16.. S, Rg .23.. X West

OPERATOR: License # 8061  
Name: OIL PRODUCERS, INC. OF KANSAS  
Address: P.O. BOX 8647  
City/State/Zip: WICHITA, KANSAS 67208  
Contact Person: JOHN S. WEIR/DIANA RICHECKY  
Phone: 316-681-0231

4950 feet from South / North line of Section  
330 feet from East / West line of Section  
IS SECTION X REGULAR IRREGULAR?  
(NOTE: Locate well on the Section Plat on Reverse Side)

CONTRACTOR: License #: 5123  
Name: PICKRELL DRILLING CO.

County: NESS  
Lease Name: MAST #1 OWWO Well #: 1  
Field Name:   
Is this a Prorated/Spaced Field? yes X no  
Target Formation(s): CHEROKEE  
Nearest lease or unit boundary: 330  
Ground Surface Elevation: 2498 feet MSL  
Water well within one-quarter mile: yes X no  
Public water supply well within one mile: yes X no  
Depth to bottom of fresh water: 220'  
Depth to bottom of usable water: 1,160'  
Surface Pipe by Alternate: 1 X 2  
Length of Surface Pipe Planned to be set: 259'  
Length of Conductor pipe required: na  
Projected Total Depth: 4119-4122'  
Formation at Total Depth: Cherokee "A"  
Water Source for Drilling Operations:  
well farm pond X other

Well Drilled For: Well Class: Type Equipment:  
.X. Oil ... Enh Rec .X. Infield .X. Mud Rotary  
... Gas ... Storage ... Pool Ext. ... Air Rotary  
.X. OWWO ... Disposal ... Wildcat ... Cable  
... Seismic; ... # of Holes ... Other  
... Other

If OWWO: old well information as follows:  
Operator: K & E PETROLEUM  
Well Name: MAST #1  
Comp. Date: 11/6/86 Old Total Depth 4575

Directional, Deviated or Horizontal wellbore? yes X no  
If yes, true vertical depth:  
Bottom Hole Location:

Will Cores Be Taken no  
If yes, proposed zone:

AFFIDAVIT

The undersigned hereby affirms that the drilling, completion and eventual plugging of this well will comply with K.S.A. 55-101, et. seq.  
It is agreed that the following minimum requirements will be met:

RECEIVED  
KANSAS CORPORATION COMMISSION  
5-19-95  
MAY 19 1995  
CONSERVATION DIVISION  
WICHITA, KS

- 1. Notify the appropriate district office prior to spudding of well;
- 2. A copy of the approved notice of intent to drill shall be posted on each drilling rig;
- 3. The minimum amount of surface pipe as specified below shall be set by circulating cement to the top; in all cases surface pipe shall be set through all unconsolidated materials plus a minimum of 20 feet into the underlying formation;
- 4. If the well is dry hole, an agreement between the operator and the district office on plug length and placement is necessary prior to plugging;
- 5. The appropriate district office will be notified before well is either plugged or production casing is cemented in;
- 6. IF AN ALTERNATE II COMPLETION, PRODUCTION PIPE SHALL BE CEMENTED FROM BELOW ANY USABLE WATER TO SURFACE WITHIN 120 DAYS OF SPUD DATE. IN ALL CASES, NOTIFY DISTRICT OFFICE PRIOR TO ANY CEMENTING.

I hereby certify that the statements made herein are true and to the best of my knowledge and belief.  
Date: 05/16/95 Signature of Operator or Agent: John S. Weir Title: President

FOR KCC USE:  
API # 15- 135-230600001  
Conductor pipe required NONE feet  
Minimum surface pipe required 240 feet per Alt. X ②  
Approved by: JK 5-22-95  
This authorization expires: 11-22-95  
(This authorization void if drilling not started within 6 months of effective date.)  
Spud date: \_\_\_\_\_ Agent: \_\_\_\_\_

REMEMBER TO:

- File Drill Pit Application (form CDP-1) with Intent to Drill;
- File Completion Form ACO-1 within 120 days of spud date;
- File acreage attribution plat according to field proration orders;
- Notify appropriate district office 48 hours prior to workover or re-entry;
- Submit plugging report (CP-4) after plugging is completed;
- Obtain written approval before disposing or injecting salt water.

Mail to: Conservation Division, 130 S. Market, Room 2078, Wichita, Kansas 67202

30  
16  
23W

**IN ALL CASES PLOT THE INTENDED WELL ON THE PLAT BELOW**

**PLAT OF ACREAGE ATTRIBUTABLE TO A WELL IN A PRORATED OR SPACED FIELD**

If the intended well is in a prorated or spaced field, please fully complete this side of the form. If the intended well is in a prorated or spaced field complete the plat below showing that the well will be properly located in relationship to other wells producing from the common source of supply. Please show all the wells within 1 mile of the boundaries of the proposed acreage attribution unit for gas wells and within 1/2 mile of the boundaries of the proposed acreage attribution unit for oil wells.

API NO. 15-  
 OPERATOR OIL PRODUCERS, INC. OF KANSAS  
 LEASE Ma#t #1 OWWO  
 WELL NUMBER 1  
 FIELD \_\_\_\_\_

LOCATION OF WELL: COUNTY Ness  
 \_\_\_\_\_ 4950 feet from south/north line of section  
 \_\_\_\_\_ 330 feet from east/west line of section  
 SECTION 30 TWP 16 RG 23W


NUMBER OF ACRES ATTRIBUTABLE TO WELL \_\_\_\_\_  
 QTR/QTR/QTR OF ACREAGE \_\_\_\_\_

IS SECTION X REGULAR or IRREGULAR  
**IF SECTION IS IRREGULAR, LOCATE WELL FROM NEAREST CORNER BOUNDARY.**

Section corner used: NE NW X SE SW

**PLAT**


(Show location of the well and shade attributable acreage for prorated or spaced wells.)  
 (Show footage to the nearest lease or unit boundary line.)

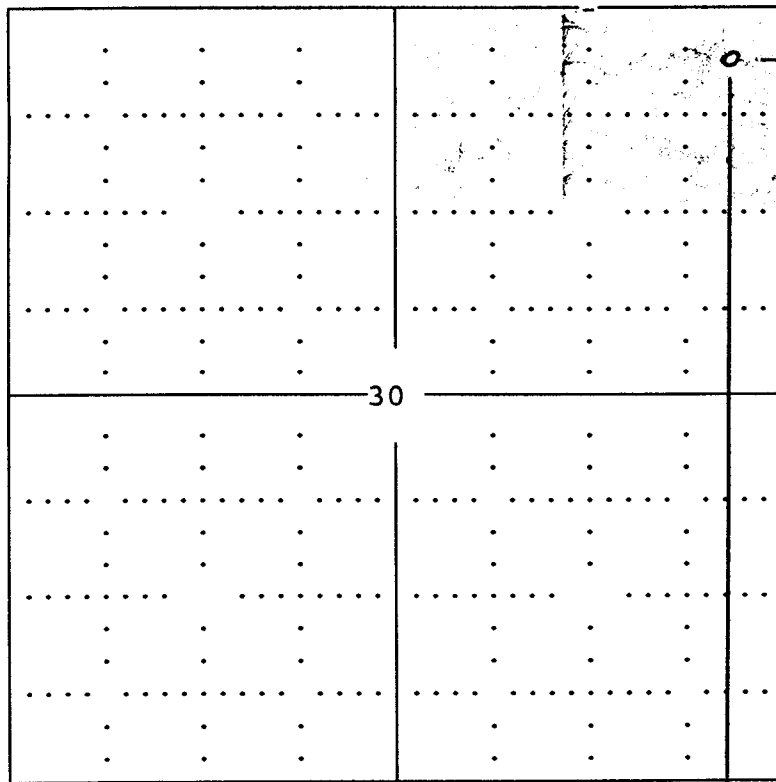

330'

**RECEIVED**  
 KANSAS CORPORATION COMMISSION

*Ness County* MAY 19 1995  
 CONSERVATION DIVISION  
 WICHITA, KS

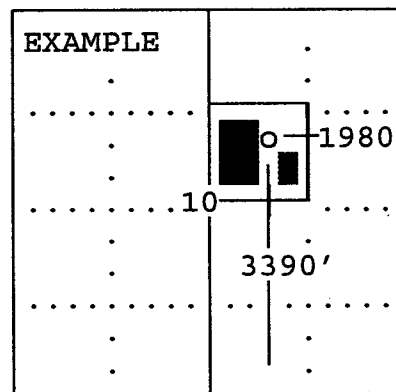

SEWARD CO.

4950'

**In plotting the proposed location of the well, you must show:**

- 1) The manner in which you are using the depicted plat by identifying section lines, i.e. 1 section, 1 section with 8 surrounding sections, 4 sections, etc.;
- 2) the distance of the proposed drilling location from the section's south/north and east/west; and
- 3) the distance to the nearest lease or unit boundary line.