

TYPE

AFFIDAVIT OF COMPLETION FORM

ACO-1 WELL HISTORY

SIDE ONE

NP 88344 Compt.

Two (2) copies of this form shall be filed with the Kansas Corporation Commission, 200 Colorado Derby Building, Wichita, Kansas 67202, within thirty (30) days after the completion of a well, regardless of how the well was completed.

Attach separate letter of request if the information is to be held confidential. If confidential, only file one copy. Information on Side One will be of public record and Side Two will then be held confidential.

Applications must be made on dual completion, commingling, salt water disposal, injection and temporarily abandoned wells.

Attach one copy only wireline logs (i.e. electrical log, sonic log, gamma ray neutron log, etc.). (Rules 82-2-105 & 82-2-125) KCC# (316) 263-3238.

LICENSE # 5181 EXPIRATION DATE 06/30/83

OPERATOR DONALD C. SLAWSON API NO. 15-101-20,775-000

ADDRESS 200 Douglas Building COUNTY Lane

Wichita, Kansas 67202 FIELD North Fork No EXT.

** CONTACT PERSON Sherry Kendall PROD. FORMATION MARM/CHER

PHONE 316-263-3201

PURCHASER Inland Crude Purch. Corp. LEASE Russell 'C'

ADDRESS 200 Douglas Building WELL NO. 2

Wichita, KS 67202 WELL LOCATION SE NE NW

DRILLING SLAWSON DRILLING CO., INC. 980 Ft. from North Line and

CONTRACTOR 200 Douglas Building ADDRESS 2020 Ft. from West Line of

Wichita, Kansas 67202 the NW (Qtr.) SEC 7 TWP 17 RGE29W (W).

PLUGGING N/A

CONTRACTOR ADDRESS

TOTAL DEPTH 4615' PBD 4553'

SPUD DATE March 24, 83 DATE COMPLETED April 18, 1983

ELEV: GR 2828 DF 2831 KB 2834


DRILLED WITH (CABLE) (ROTARY) (X) TOOLS.

DOCKET NO. OF DISPOSAL OR REPRESSURING WELL BEING USED TO DISPOSE OF WATER FROM THIS LEASE CD-10787

Amount of surface pipe set and cemented 458' DV Tool Used? No

THIS AFFIDAVIT APPLIES TO: (Circle ONE) - Oil, Gas, Shut-in Gas, Dry, Disposal, Injection, Temporarily Abandoned, OWWO. Other

ALL REQUIREMENTS OF THE STATUTES, RULES AND REGULATIONS PROMULGATED TO REGULATE THE OIL AND GAS INDUSTRY HAVE BEEN FULLY COMPLIED WITH.

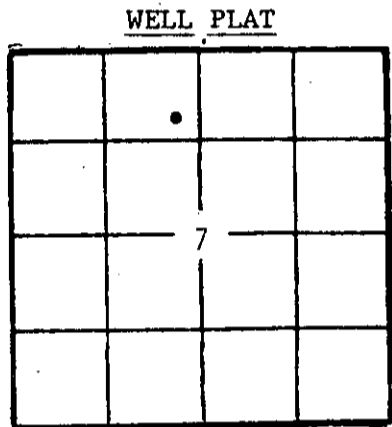

(Office Use Only) KCC [checked] KGS [checked] SWD/REP PLG.


A F F I D A V I T

William R. Horigan, being of lawful age, hereby certifies that:

I am the Affiant, and I am familiar with the contents of the foregoing Affidavit. The statements and allegations contained therein are true and correct.

Signature of William R. Horigan (Name) William R. Horigan 20th day of June

SUBSCRIBED AND SWORN TO BEFORE ME this 20th day of June 19 83.

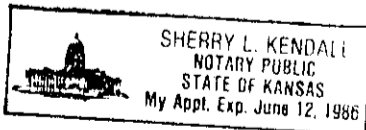

Signature of Sherry L. Kendall (NOTARY PUBLIC) Sherry L. Kendall RECEIVED STATE CORPORATION COMMISSION

MY COMMISSION EXPIRES: 06/12/86

** The person who can be reached by phone regarding any questions concerning this information.

JUL 07 1983

CONSERVATION DIVISION Wichita, Kansas

07-07-1983