


WELL PLUGGING RECORD

Give All Information Completely
Make Required Affidavit
Mail or Deliver Report to:
Conservation Division
State Corporation Commission
800 Bittling Building
Wichita, Kansas

Saline County, Sec. 31 Twp. 16 Rge. 14 (X) XXXXX

NORTH

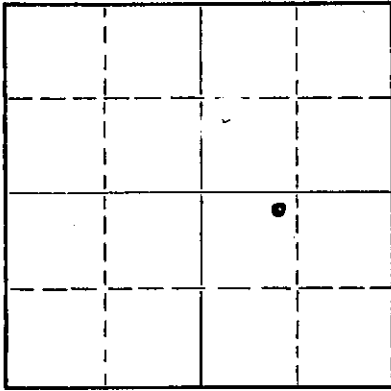

Locate well correctly on above Section Plat

Location as "NE/CNW/SW" or footage from lines NE NW SE
Lease Owner E. K. Carey, Contractor
Lease Name VanMeter Well No. 1
Office Address Box 620, McPherson, Kansas
Character of Well (completed as Oil, Gas or Dry Hole) Dry
Date well completed December 12, 19 54
Application for plugging filed December 11, 19 54
Application for plugging approved December 11, 19 54
Plugging commenced December 11, @ 11:30 PM 19 54
Plugging completed December 12, @ 2:30 PM 19 54
Reason for abandonment of well or producing formation Dry Hole

If a producing well is abandoned, date of last production _____ 19____
Was permission obtained from the Conservation Division or its agents before plugging was commenced? Yes

Name of Conservation Agent who supervised plugging of this well Ruel Durkee
Producing formation _____ Depth to top _____ Bottom _____ Total Depth of Well 2710 Feet
Show depth and thickness of all water, oil and gas formations.

OIL, GAS OR WATER RECORDS

CASING RECORD

FORMATION	CONTENT	FROM	TO	SIZE	PUT IN	PULLED OUT
				8-5/8	156	None

Describe in detail the manner in which the well was plugged, indicating where the mud fluid was placed and the method or methods used in introducing it into the hole. If cement or other plugs were used, state the character of same and depth placed, from _____ feet to _____ feet for each plug set.

Gunned pits circulated heavy mud on bottom and half way out hole, ran measuring line and filled with heavy mud to 153'. Made bridge with limbs and rock to hold weight of 5 joints of drill pipe, mixed 15 sacks cement and put on bridge. Ran Measuring line and filled to 25'. Put half sack ^{with mud} hulls there and mixed 5 sacks cement and filled to bottom of cellar floor. Through plugging @ 2:30, December 12, 1954.

12-14-54 ^{END}

(If additional description is necessary, use BACK of this sheet)
Name of Plugging Contractor E. K. Carey, Contractor
Address Box 620, McPherson, Kansas

STATE OF Kansas, COUNTY OF McPherson, ss.
Arland Bruce (employee of owner) or (owner or operator) of the above-described well, being first duly sworn on oath, says: That I have knowledge of the facts, statements, and matters herein contained and the log of the above-described well as filed and that the same are true and correct. So help me God.

(Signature) Arland Bruce
Box 620, McPherson, Kansas
(Address)

SUBSCRIBED AND SWORN TO before me this 13th day of December, 1954

My commission expires November 13, 1956

[Signature]
Notary Public.

PLUGGING
FILE SEC 31 T 16 R 14
BOOK PAGE 83 LINE 42

E. K. Carey, Contractor
Box 620
McPherson, Kansas

Elevations: 1384 K.B.
1321 D.F.
1319 Gr.

VanMeter #1

NE NW SE/4
Sec. 31-16-1E
Saline County, Kansas

Casing Record:
8-5/8" @ 150' @/100' sks
cement and 100' cc

Well Commenced: 12-1-54
Well Completed: 12-18-54 D & A

Contractor: E. K. Carey, Contractor, Rig #2, Box 620, McPherson, Kansas
Geologist: Don Holler, E. K. Carey Drilg. Co. 815 Central Bldg. Wichita

Figures Indicate Bottom of Formation K. E.

Cellar	7	Geologist Tests:	
Shale	35	Heehner	1860
Shale and lime	147	Douglas	1880
Anhydrite	153	Lansing	2084
Lime	345	Conglomerate	2538
Lime and shale	740	Miss. Chat	2696
Lime	830	Rotary Total Depth	2710
Shale and lime	1090		
Shale and lime shells	1235		
Shale and lime	1480		
Lime	1605		
Lime and shale	1800		
Lime	1880		
Sand	1920		
Shale and lime	1970		
Shale and shells	2060		
Lime	2212		
Lime and shale	2255		
Lime	2420		
Shale and lime	2694		
Miss. Chat	2710 TD		

This is to certify that the above information is to the best of my knowledge true and correct,

SUBSCRIBED AND SWORN to before me this 13th day of December, 1954

E. K. CAREY, CONTRACTOR

BY Herbert Maeton
Herbert Maeton, Superintendent

My Commission Expires: November 13, 1956

PLUGGING
FILE SEC. 31-16-1E
BOOK PAGE 13 LINE 42

RECEIVED
DIVISION