


WELL PLUGGING RECORD

Give All Information Completely
Make Required Affidavit
Mail or Register Report to:
Conservation Division
State Corporation Commission
808 Bitting Building
Wichita, Kansas

NORTH

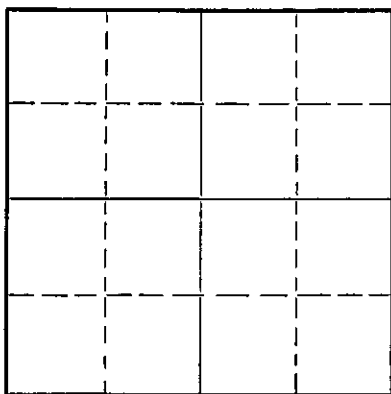

Locate well correctly on above
Section Plat

Saline County. Sec. 31 Twp. 16 Rge. (E) 1 (W)

Location as "NE/CNW $\frac{1}{4}$ SW $\frac{1}{4}$ " or footage from lines SE SE SE
Lease Owner Westgate-Greenland Oil Company
Lease Name W. Van Meter Estate Well No. 1
Office Address 1022 Union National Bank Bldg. Wichita 2, Kansas
Character of Well (completed as Oil, Gas or Dry Hole) dry hole
Date well completed June 15, 1950 19
Application for plugging filed July 8, 1950 19
Application for plugging approved July 10, 1950 19
Plugging commenced July 21, 1950 19
Plugging completed July 24, 1950 19
Reason for abandonment of well or producing formation

If a producing well is abandoned, date of last production 19
Was permission obtained from the Conservation Division or its agents before plugging was commenced? yes

Name of Conservation Agent who supervised plugging of this well Ruel Durkee
Producing formation Depth to top Bottom Total Depth of Well Feet
Show depth and thickness of all water, oil and gas formations.

OIL, GAS OR WATER RECORDS

CASING RECORD

Formation	Content	From	To	Size	Put In	Pulled Out
Surface		0	150	8 5/8"	150	None
Mississippi Lime			2680	5 1/2"	2680	2251.95'

Describe in detail the manner in which the well was plugged, indicating where the mud fluid was placed and the method or methods used in introducing it into the hole. If cement or other plugs were used, state the character of same and depth placed, from feet to feet for each plug set.

Filled hole with heavy mud from 2680 to 2670 feet
Run 6 sacks cement from 2670 feet to 2630 feet
Filled with heavy mud from 2630 to 145 feet and
Run 15 sacks cement filling to 105 feet
Filled with heavy mud from 105 feet to 12 feet and
Run 5 sacks cement to cellar base.

RECORDED

AUG 15 1950

STATE CORPORATION COMMISSION

(If additional description is necessary, use BACK of this form)

Correspondence regarding this well should be addressed to Westgate-Greenland Oil Company
Address 1022 Union National Bank Building, Wichita 2, Kansas

STATE OF Kansas, COUNTY OF Sedgwick, ss.
G. E. Bitler (employee of owner) or (owner or operator) of the above-described well,
being first duly sworn on oath, says: That I have knowledge of the facts, statements, and matters herein contained and the log of the above-described well as filed and that the same are true and correct. So help me God.

(Signature) G. E. Bitler


1022 Union National Bank Bldg., Wichita 2, Ks
(Address)

SUBSCRIBED AND SWORN TO before me this 14th day of August, 1950

Esther Russell

Notary Public.

My commission expires May 25, 1953

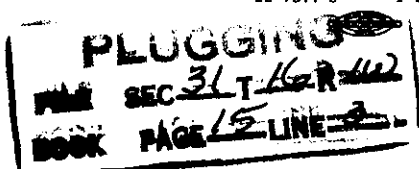

15769.00069.0000

COMPANY: Westgate Greenland Oil Co.
 CONTRACTOR: Jackson Drilling Corporation
 FARM: W. Van Meter #1
 LOCATION: SE SE SE Section 31-16-1W,
 Saline County, Kansas
 ELEVATION: 1330
 COMMENCED: June 7, 1950
 COMPLETED: June 15, 1950

0	to	150	Clay, Sand and Shells
150	to	300	Shale and Shells
300	to	525	Lime and Shale
525	to	668	Sandy Lime and Shale
668	to	900	Sandy Lime
900	to	1625	Lime and Shale
1625	to	1715	Shale
1715	to	1825	Lime
1825	to	1870	Lime and Shale
1870	to	1950	Shale and Shells
1950	to	2040	Shale
2040	to	2082	Lime
2082	to	2231	Shale and Lime
2231	to	2330	Lime
2330	to	2494	Lime and Shale
2494	to	2552	Shale and Shells
2552	to	2655	Shale
2655	to	2680	Mississippi Lina
		2682	T.D.
		2682	T. D. Gardwell

8 5/8" casing set at 150 feet. Cemented with 125 sacks cement and 1 sack cal-
 5 1/2" casing set at 2675 feet. Cemented with 100 sacks cement.

Top: Mississippi 2680 (2689) DF

1000 gallons Dowell Service

Dry

All measurements from top of derrick floor.

RECEIVED
 STATE CORPORATION
 COMMISSION
 JUN 10 1950
 STATE CORPORATION
 COMMISSION
 KANSAS

C E R T I F I C A T E

I, Clare A. Stewart, do hereby certify that the above and foregoing is a true and correct copy of log of the W. Van Meter #1, Section 31-16-1W, Saline County, Kansas, as reflected by files of the Jackson Drilling Corporation.

Clare A. Stewart
 Clare A. Stewart

Subscribed and sworn to before me, a Notary Public, within and for Johnson County, Kansas this 30th day of June 1950.

Dorothy J. Wilson
 Dorothy J. Wilson

My Commission Expires November 30, 1950.

PLUGGING
 FILE SEC 31T 16R 1W
 BOOK PAGE 15 LINE 3