

STATE OF KANSAS
STATE CORPORATION COMMISSION

Give All Information Completely
Make Required Affidavit
Mail or Deliver Report to:
Conservation Division
State Corporation Commission
211 No. Broadway
Wichita, Kansas

WELL PLUGGING RECORD

Saline County. Sec. 31 Twp. 16 Rge. (E) 1 (W)

Location as "NE/CNW%SW%" or footage from lines SE NW SW

Lease Owner Melland Drilling Co., Inc.

Lease Name Van Meter Well No. 1

Office Address Box 783 McPherson, Kansas

Character of Well (completed as Oil, Gas or Dry Hole) dry hole

Date well completed Feb. 7 1965

Application for plugging filed " 1965

Application for plugging approved " 1965


Plugging commenced " 1965

Plugging completed " 1965

Reason for abandonment of well or producing formation dry hole

If a producing well is abandoned, date of last production 19

Was permission obtained from the Conservation Division or its agents before plugging was commenced? yes

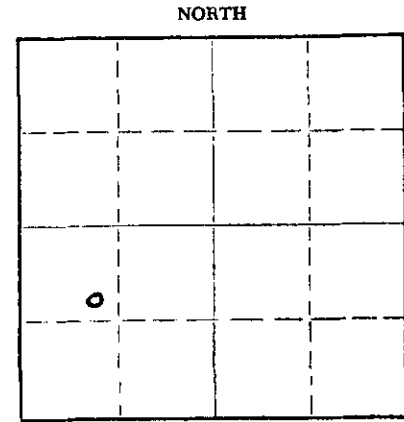

Locate well correctly on above Section Plat

Name of Conservation Agent who supervised plugging of this well Gilbert Toman

Producing formation Depth to top Bottom Total Depth of Well 2750 Feet

Show depth and thickness of all water, oil and gas formations.

OIL, GAS OR WATER RECORDS

CASING RECORD

FORMATION	CONTENT	FROM	TO	SIZE	PUT IN	PULLED OUT
				8 5/8"	139'	none

Describe in detail the manner in which the well was plugged, indicating where the mud fluid was placed and the method or methods used in introducing it into the hole. If cement or other plugs were used, state the character of same and depth placed, from feet to feet for each plug set.

heavy mud		2750'	to	135'
wooden plug & 1/2" x hulls @				135'
20sx cement on plug				
heavy mud			to	40'
wooden plug & 1/2" x hulls @				40'
10sx cement on plug				
surface soil		5'	to	0'

RECEIVED
STATE CORPORATION COMMISSION

FEB 16 1965

CONSERVATION DIVISION
Wichita, Kansas

(If additional description is necessary, use BACK of this sheet)

Name of Plugging Contractor Melland Drilling Co., Inc.

Address Box 783 McPherson, Kansas

STATE OF Kansas, COUNTY OF McPherson, ss.

Donald J. Melland (employee of owner) or (owner of well) of the above-described well, being first duly sworn on oath, says: That I have knowledge of the facts, statements, and matters herein contained and the log of the above-described well as filed and that the same are true and correct. So help me God.

(Signature) Donald J. Melland

Box 783 McPherson, Kansas (Address)

SUBSCRIBED AND SWORN TO before me this 15th day of February, 1965

My commission expires December 23, 1967

Notary Public.

15-169-30006-0000

WELL RECORD

LEASE: **Van Meter** WELL NO: **1** ELEVATION: **1376 RB**
 LOCATION: **SE NW SW** COMMENCED: **2/2/65**
Sec. 31-16-1W COMPLETED: **2/7/65**
 OPERATOR: **Melland Drilling Co., Inc.**
 CONTRACTOR: **Melland Drilling Company, Inc.**
Post Office Box 783
McPherson, Kansas
 CASING RECORD: **8 5/8" @ 139'/90ax**

FORMATION	LOG
clay & shale	139
lime & shale	800
shale	1030
shale & shells	1765
lime & shale	1824
shale & sand	2050
shale & lime	2138
lime & shale	2670
shale	2730
Mississippi	2750
RTD	2750
Sample Tops	
Lansing	2129
Mississippi	2730

FORMATION	LOG
-----------	-----

RECEIVED
 STATE CORPORATION COMMISSION
 FEB 16 1965
 CONSERVATION DIVISION
 Wichita, Kansas

CERTIFICATE

State of Kansas, County of McPherson, ss.

I, Donald J. Melland, do hereby certify that the above is a true and correct copy of the log of the above named and described well, as reflected by the records of the Melland Drilling Company, Inc.

Donald J. Melland

Subscribed and sworn to before me, a Notary Public, in and for the County of McPherson, State of Kansas,

this 15th day of February, 1965

My Commission expires: December 23, 1967

James B. Melland
Notary Public