


WELL PLUGGING RECORD

Give All Information Completely
Make Required Affidavit
Mail of Deliver Report to:
Conservation Division
State Corporation Commission
211 No. Broadway
Wichita, Kansas

NORTH

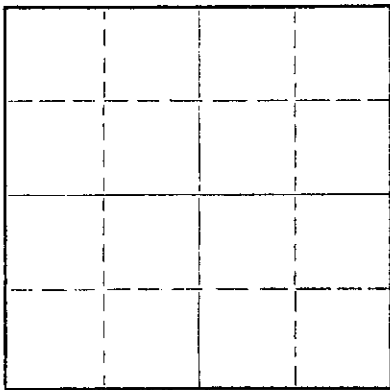

Locate well correctly on above
Section Plat

Saline County. Sec. 30 Twp. 16S Rge. (E) 1 (W)
Location as "NE/CNW&SW&" or footage from lines C = S/2 SE SE
Lease Owner /Glickman Oil - Houston Petroleum
Lease Name Reese Well No. 4
Office Address 702 S. St. Francis, Wichita 2, Kansas
Character of Well (completed as Oil, Gas or Dry Hole) Dry Hole
Date well completed September 27 19 61
Application for plugging filed September 27 19 61
Application for plugging approved September 27 19 61
Plugging commenced September 27 19 61
Plugging completed September 27 19 61
Reason for abandonment of well or producing formation

If a producing well is abandoned, date of last production 19
Was permission obtained from the Conservation Division or its agents before plugging was commenced? Yes

Name of Conservation Agent who supervised plugging of this well Cecil Jones
Producing formation Depth to top Bottom Total Depth of Well 2725 Feet
Show depth and thickness of all water, oil and gas formations.

OIL, GAS OR WATER RECORDS

CASING RECORD

FORMATION	CONTENT	FROM	TO	SIZE	PUT IN	PULLED OUT
				8-5/8	146	NONE

Describe in detail the manner in which the well was plugged, indicating where the mud fluid was placed and the method or methods used in introducing it into the hole. If cement or other plugs were used, state the character of same and depth placed, from feet to feet for each plug set.

Filled hole to 160 ft. Set plug & Hulls Cement w/20 sxs.
Filled hole to 35 ft. Set plug & hulls. Cement w/8 sxs.
Put 2 sxs. in Rat Hole.

(If additional description is necessary, use BACK of this sheet)

Name of Plugging Contractor Glickman Oil Company
Address P. O. Box 3104 - Washington St. Station, Wichita 2, Kansas

STATE OF Kansas, COUNTY OF Sedgwick, ss.
Milton Glickman (employee of owner) or (owner or operator) of the above-described well, being first duly sworn on oath, says: That I have knowledge of the facts, statements, and matters herein contained and the log of the above-described well as filed and that the same are true and correct. So help me God.

(Signature) [Signature]
702 S. St. Francis, Wichita 2, Kansas
(Address)

SUBSCRIBED AND SWORN TO before me this 2nd day of October, 19 61

My commission expires November 19, 1963

[Signature]
Notary Public.



GLICKMAN OIL COMPANY

P. O. Box 3108
Wichita, Kansas

15-169-00753-0000

DRILLERS WELL LOG

Company: Glickman Oil - Houston Petroleum

Location: C - S/2 SE SE

Sec. 30-168-1W

Farm: Reese

Well No. 4

Saline County, Kansas

Commenced: September 21, 1961

Elevation: 1359 RB

Completed: September 27, 1961

Total Depth: 2725'

Casing: 8-5/8" @146' w/115 sxz.

Production: D & A

Geologist - M. W. Smith

Figures Indicate Bottom of Formations

20	Surface Soil & Clay		
146	Shale & Lime		
740	Lime & Shale		
1690	Shale & Lime		
1830	Lime & Shale Streaks		
1935	Lime & Shale		
2075	Shale & Lime		
2091	Shale		
2290	Lime		
2435	Lime w/shale		
2718	Shale & Lime		
2725	Miss (Chat)		
2725	RTD.		

		<u>TBPS</u>	
		Hebner	1873
		Toronto	1888
		Douglas	1984
		Brown Lime	2026
		Lansing	2091
		Base Kansas City	2430
		Mississippi	2718

RECEIVED
STATE CORPORATION COMMISSION
OCT 23 1961
CONSERVATION DIVISION
Wichita, Kansas

STATE OF KANSAS, COUNTY OF SEDGWICK, ss:

I, Milton Glickman, of the Glickman Oil Company, upon oath state that the above and foregoing is a true and correct copy of the log of the Reese #4

Milton Glickman
Milton Glickman

Subscribed and sworn to before me this 2nd day of October, 1961

Lorella Schauf
Lorella Schauf Notary Public

My Commission Expires: November 19, 1963