


STATE OF KANSAS
STATE CORPORATION COMMISSION

Give All Information Completely
Make Required Affidavit
Mail or Deliver Report to:
Conservation Division
State Corporation Commission
211 No. Broadway
Wichita, Kansas

WELL PLUGGING RECORD

NORTH

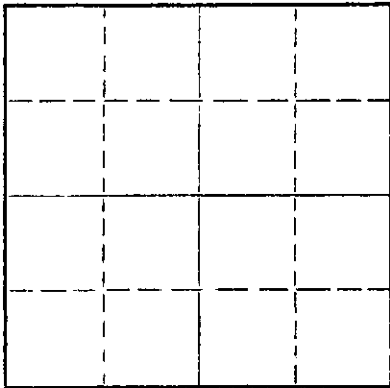

Locate well correctly on above
Section Plat

Saline County. Sec. 30 Twp. 16S Rge. 1 W (E) (W)
Location as "NE/CNW/SW" or footage from lines NE NW SE
Lease Owner Glickman Oil Co.
Lease Name Reese Well No. 3
Office Address P.O. Box 3108 Wichita, Kansas
Character of Well (completed as Oil, Gas or Dry Hole) oil
Date well completed 12-23 19 60
Application for plugging filed July 19 64
Application for plugging approved July 19 64
Plugging commenced July 14 19 64
Plugging completed July 17 19 64
Reason for abandonment of well or producing formation Went dry.

If a producing well is abandoned, date of last production 19
Was permission obtained from the Conservation Division or its agents before plugging was commenced? Yes

Name of Conservation Agent who supervised plugging of this well # Gilbert Toman
Producing formation Depth to top Bottom Total Depth of Well 2671' Feet
Show depth and thickness of all water, oil and gas formations.

OIL, GAS OR WATER RECORDS

CASING RECORD

| FORMATION | CONTENT | FROM | TO | SIZE | PUT IN | PULLED OUT |
|-----------|---------|------|----|--------|--------|------------|
| | | | | 5 1/8" | | 2204' |
| | | | | | | |
| | | | | | | |
| | | | | | | |
| | | | | | | |

Describe in detail the manner in which the well was plugged, indicating where the mud fluid was placed and the method or methods used in introducing it into the hole. If cement or other plugs were used, state the character of same and depth placed, from feet to feet for each plug set.

Plugged off bottom of hole with rock. Rock from 2671' to 2655'. Dumped 5 sx of cement. Mudded hole to 155'. Made 10' of rock bridge and dumped 20 sx of cement. Mudded hole to 35'. Made 5' of cement, filling to the bottom of the celler.

RECEIVED
STATE CORPORATION COMMISSION

JUL 22 1964

CONSERVATION DIVISION
Wichita, Kansas

(If additional description is necessary, use BACK of this sheet)

Name of Plugging Contractor Art Lamb Casing Pulling Co.
Address 2809 King St. Hutchinson, Kansas

STATE OF Kansas, COUNTY OF Reno, ss.
Art Lamb (employee of owner) or (owner or operator) of the above-described well, being first duly sworn on oath, says: That I have knowledge of the facts, statements, and matters herein contained and the log of the above-described well as filed and that the same are true and correct. So help me God.

(Signature) Art Lamb
2809 King St. Hutchinson, Kansas
(Address)

SUBSCRIBED AND SWORN TO before me this 20 th day of July, 1964

My commission expires January 5, 1966

Judy Lamb
Notary Public.

GLICKMAN OIL COMPANY

P.O. Box 8108

Wichita, Kansas

15-169-005 47-0000

DRILLERS WELL LOG

Company: Glickman Oil & ~~Service~~ Co. Location: NE NW SE 30-169-1W
West Saline County, Kansas

Farm: Range Well No. 1

Commenced: December 17, 1959 Elevation: 1321 ft

Completed: December 23, 1959

Total Depth: 2871

Casing: 134' 3-4" w/120 sacks Production: open hole
250' 1-1/2" w/70 sacks

Figures indicate Bottom of Formations

| | | | |
|------|---------------------|----------------------|------|

RECEIVED
STATE CORPORATION COMMISSION

JUL 22 1964

CONSERVATION DIVISION
Wichita, Kansas

com 14
over 17

2653.5
145 20
top 10

STATE OF KANSAS, COUNTY OF SEDGWICK, ss:

I, Milton Glickman of the Glickman Oil Company, upon oath state that the above and foregoing is a true and correct copy of the log of the Range 22 Well 44

Milton Glickman
Milton Glickman

Subscribed and sworn to before me this 24th day of January, 1961

Lorella Schaefer
Lorella Schaefer
Notary Public

My Commission Expires: November 19, 1963