


STATE OF KANSAS
STATE CORPORATION COMMISSION

Form CP-4

WELL PLUGGING RECORD

Give All Information Completely
Make Required Affidavit
Mail or Deliver Report to:
Conservation Division
State Corporation Commission
P. O. Box 17027
Wichita, Kansas 67217
NORTH

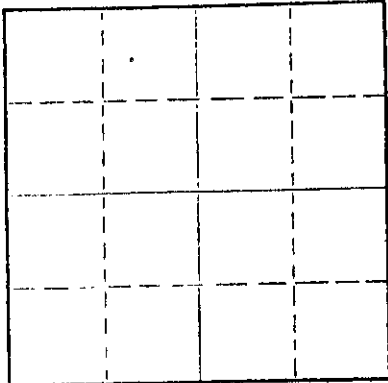

Locate well correctly on above
Section Plat

Saline County, Sec. 30 Twp. 16 Rge. 1 (E) (W)
Location as "NE/CNW/SE" or footage from lines NE NE SE
Lease Owner Raymond Oil Co., Inc.
Lease Name Reese #1 Well No.
Office Address Wichita, Kansas 67202
Character of Well (completed as Oil, Gas or Dry Hole)
Date well completed 19
Application for plugging filed 19
Application for plugging approved 19
Plugging commenced 4/1/74 19
Plugging completed 4/10/74 19
Reason for abandonment of well or producing formation depleted.
If a producing well is abandoned, date of last production 19
Was permission obtained from the Conservation Division or its agents before plugging was commenced? yes

Name of Conservation Agent who supervised plugging of this well Toman
Producing formation Depth to top Bottom Total Depth of Well 2673 Feet
Show depth and thickness of all water, oil and gas formations.

OIL, GAS OR WATER RECORDS

CASING RECORD

FORMATION	CONTENT	FROM	TO	SIZE	PUT IN	PULLED OUT
				10-3/4"	158	none
				7"	2669	1596'

Describe in detail the manner in which the well was plugged, indicating where the mud fluid was placed and the method or methods used in introducing it into the hole. If cement or other plugs were used, state the character of same and depth placed, from feet to feet for each plug set.

Checked bottom, ran sand to 2650' and dumped 6 sacks of cement.
Shot pipe at 2131', 2038', mud came in to 1409'. Pumped 80 barrels
water, circulated out mud. Shot pipe at 1919', 1818', 1723',
1631', pulled 63 joints of 7". Set 20' rock bridge at 195' and
dumped 4 yards ready mix.

PLUGGING COMPLETE.

RECEIVED
STATE CORPORATION COMMISSION
APR 16 1974
CONSERVATION DIVISION
Wichita, Kansas

(If additional description is necessary, use BACK of this sheet)
Name of Plugging Contractor KNIGHT CASING PULLING CO., INC.
Address CHASE, KANSAS

STATE OF KANSAS, COUNTY OF RICE, SS.
NOEL J. KNIGHT (employee of owner) or (owner or operator) of the above-described well, being first duly sworn on oath, says: That I have knowledge of the facts, statements, and matters herein contained and the log of the above-described well as filed and that the same are true and correct. So help me God.

(Signature) Noel Knight
CHASE, KANSAS
(Address)

Subscribed and Sworn to before me this 11th day of April, 1974
MARGARET MELCHER
NOTARY PUBLIC
Rice County, Kansas
My Commission Expires Feb. 15, 1975
Margaret Melcher
Notary Public.



15-169.00181.0000

WELL LOG BUREAU--KANSAS GEOLOGICAL SOCIETY


508 East Murdock, Wichita, Kansas

Company- HOUSTON PETROLEUM &
Farm- GLICKMAN OIL
Reese No. 1

SEC. 30 T. 16 R. 1W
NE NE SE

Total Depth. 2673'
Comm. 7-11-60 Comp. 7-19-60
Shot or Treated.
Contractor. Glickman Oil Co.
Issued. 10-1-60

County Saline
KANSAS

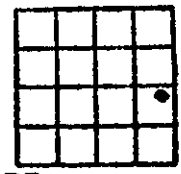

Elevation. 1333' RB

Production. 25 BOPD

CASING:

10 3/4" @ 158' w/125 sks. cem.
7" @ 2669' w/75 sks. cem.

Figures Indicate Bottom of Formations.

shale	40
shale & lime	158
lime	270
lime & shale	680
lime	760
lime & shale	845
shale & lime	1200
lime & shale	1250
shale & lime	1315
shale w/ lime strks.	1565
shale & lime	1730
lime & shale	1845
shale & lime	2030
lime & shale	2237
lime	2315
lime & shale	2650
shale	2657
lime	2667
chat	2673 WTD ✓
Total Depth	

SCOUT TOPS:

Heebner	1840
Douglas	1860
Brown Lime	1986
Lansing	2055
Mississippi	2657

RECEIVED
STATE CORPORATION COMMISSION
MAR 20 1974
CONSERVATION DIVISION
Wichita, Kansas