


WELL PLUGGING RECORD

Give All Information Completely
Make Required Affidavit
Mail or Deliver Report to:
Conservation Division
State Corporation Commission
800 Bitting Building
Wichita, Kansas

Saline County. Sec. 30 Twp. 16 Rge. 1 (E) (W) X
No. NE

NORTH

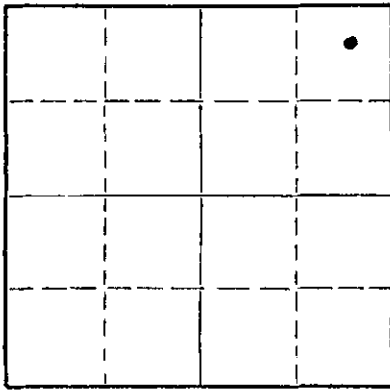

Locate well correctly on above Section Plat

Location as "NE/CNW/SW" or footage from lines
Lease Owner Louis Kahan
Lease Name Ellis Well No. 1
Office Address Box 682 Tulsa, Okla.
Character of Well (completed as Oil, Gas or Dry Hole) Oil
Date well completed Mar. 4, 1953
Application for plugging filed 19____
Application for plugging approved 19____
Plugging commenced June 19 1957
Plugging completed June 26 1957
Reason for abandonment of well or producing formation Depleted

If a producing well is abandoned, date of last production Do Not Know 19____
Was permission obtained from the Conservation Division or its agents before plugging was commenced? Yes

Name of Conservation Agent who supervised plugging of this well Ruel Durkee
Producing formation 2655 Depth to top 2652 Bottom 2655 Total Depth of Well 2655 Feet
Show depth and thickness of all water, oil and gas formations.

OIL, GAS OR WATER RECORDS

CASING RECORD

FORMATION	CONTENT	FROM	TO	SIZE	PUT IN	PULLED OUT
Mississippi Chat						

Describe in detail the manner in which the well was plugged, indicating where the mud fluid was placed and the method or methods used in introducing it into the hole. If cement or other plugs were used, state the character of same and depth placed, from _____ feet to _____ feet for each plug set.

Filled back with gravel to 2600'. Dumped 6 sacks of cement. Shot pipe off at 2400'. Pulled pipe and mudded hole to 180'. Set rock bridge and dumped 20 sacks of cement. Finished mudding hole and dumped 5 sacks of cement at base of cellar.

(If additional description is necessary, use BACK of this sheet)

Name of Plugging Contractor _____
Address _____

STATE OF Kans., COUNTY OF Reno, ss.
Employee (employee of owner) or (owner or operator) of the above-described well, being first duly sworn on oath, says: That I have knowledge of the facts, statements, and matters herein contained and the log of the above-described well as filed and that the same are true and correct. So help me God.

(Signature) Best Lee
R. R. #4, Hutchinson, Kans. (Address)

SUBSCRIBED AND SWORN to before me this 1st day of July, 1957

My commission expires August 12, 1957

Storothy Lee
Notary Public.

PLUGGING
FILE SEC 30 T. 16 R. 1W
BOOK PAGE 20 LINE 17

RECEIVED
STATE CORPORATION COMMISSION

JUL 25 1957

CONSERVATION DIVISION
Wichita, Kansas

ROTARY DRILLER'S LOG

15-169-00902-0000

E. K. Carey Drilling Co., Inc., Operator
 Box 620
 McPherson, Kansas

Elevation: 1315 K. B.

8-5/8" x 5 1/2" Head 6.35'
 below K. B.

Well #1

Casing Record:

O, NE NE NE
 Sec. 30-16-1W
 Saline County, Kansas

8-5/8" @ 123' w/35 sz.
 5 1/2" 2642' 50 sz.

Well Commenced: 2-17-53
 Well Completed: 2-24-53

Cemented 1' off bottom

Contractor: Mallard Drilling Co. 1016 Union Natl. Bank Bldg. Wichita, Kansas
 Geologist: Don Holler, E. K. Carey Drig. Co. 815 Central Bldg. Wichita "

Figures Indicate Bottom of Formation K. B.

Cellar & R.T.	0
Shale & shells	128
Lime	655
Lime & sand	820
Shale & lime	1565
Lime	1920
Shale & lime	1995
Shale	2038
Lime	2560
Lime & shale	2455
Shale & lime	2641
Mississippi	2643 TD

This is to certify that the above information is to the best of my knowledge true and correct.

SUBSCRIBED AND SWORN to before me this 25th day of February, 1953

E. K. CAREY DRILLING COMPANY INC.

BY Herbert P. Gorton
 Herbert P. Gorton, Superintendent

PLUGGING
 FILE SEC 30 T 16 R 1W
 BOOK PAGE 65 LINE 22
 20 17

RECEIVED NP
 STATE CORPORATION COMMISSION

My Commission Expires November 13, 1956

FEB 11 1957

CONSERVATION DIVISION
 Wichita, Kansas

ROTARY DRILL R'S LOG

E. K. Carey Contractor
 Box 620
 McPherson, Kansas
 Ellis #1

Elevation: 1315 K.B.

8-5/8" x 5 1/2" Head 6.35'
 below K. B.

Casing Record:

8-5/8" @ 128' w/85 sks,
 5-1/2" 2642' w/50 sks.

Cemented 1' off bottom

C, NE NE NE
 Sec. 30-16-1W
 Saline County, Kansas

Well Commenced: 2-17-53
 Well Completed: 2-24-53

Contractor: Mallard Drilling Co. 1016 Union Nat'l. Bank Bldg, Wichita
 Geologist: Don Hollar, E. K. Carey Drig. Co. 815 Central Bldg, Wichita

Figures Indicate Bottom of Formation K. B.

cellar	8
shale and shells	128
lime	655
lime and sand	820
shale and lime	1565
lime	1980
shale and lime	1995
shale	2036
lime	2360
lime and shale	2455
shale and lime	2641
Miss. lime	2643 TD

Cable Tool Completion: February 25 to March 4, 1953

Drilled 12' deeper to 2655. March 1st, acidized by Chemical-Process with 500 gals. Completed 1-3/4 barrels per hour, 25% water.

Reacidized by Chemical-Process March 26, 1953 with 1000 gals. Reacidized by Chemical-Process October 26, 1955 with 2000 gals., Jell acid, 1350# max. pressure, increase the water to 278 barrels per day and the oil to approximately 10 barrels per day

Quit pumping May 22, 1956, because of salt water. Well averaging 7 bbls. oil and 281 bbls. water per day last week pumped.

This is to certify that the above information is to the best of my knowledge true and correct.

SUBSCRIBED AND SWORN to before me this 6th day of December, 1956

E. K. CAREY CONTRACTOR

RECEIVED
 STATE CORPORATION COMMISSION
 DEC 7 - 1956
 CONSERVATION DIVISION
 Wichita, Kansas

Herbert Rhoton
 Herbert Rhoton, Superintendent

J. J. [Signature]

My Commission Expires:

November 13, 1960

PLUGGING
 FILE SEC 30 T. 16 R. 1W
 BOOK PAGE 65 LINE 22

NP