


Give All Information Completely
Make Required Affidavit
Mail or Deliver Report to:
Conservation Division
State Corporation Commission
800 Biting Building
Wichita, Kansas

15-165-00205-0000

WELL PLUGGING RECORD

NORTH

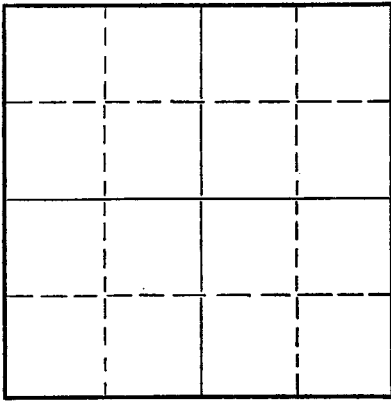

Locate well correctly on above
Section Plat

Rush County. Sec. 9 Twp. 18 Rge. (E) 18 (W)
Location as "NE/CNW/SW" or footage from lines SE SE SE
Lease Owner Rupp-Ferguson Oil Co.
Lease Name Young Well No. 1
Office Address 523 Petroleum Bg., Wichita, Kansas
Character of Well (completed as Oil, Gas or Dry Hole) Dry Hole
Date well completed 6-7-54 19
Application for plugging filed 6-7-54 19
Application for plugging approved 6-7-54 19
Plugging commenced 6-7-54 19
Plugging completed 6-7-54 19
Reason for abandonment of well or producing formation _____

If a producing well is abandoned, date of last production _____ 19
Was permission obtained from the Conservation Division or its agents before plugging was commenced? Yes

Name of Conservation Agent who supervised plugging of this well Eldon Petty
Producing formation _____ Depth to top _____ Bottom _____ Total Depth of Well 3900 Feet
Show depth and thickness of all water, oil and gas formations.

OIL, GAS OR WATER RECORDS

CASING RECORD

FORMATION	CONTENT	FROM	TO	SIZE	PUT IN	PULLED OUT
				8 5/8	1012	0

Describe in detail the manner in which the well was plugged, indicating where the mud fluid was placed and the method or methods used in introducing it into the hole. If cement or other plugs were used, state the character of same and depth placed, from _____ feet to _____ feet for each plug set.

Filled hole to 350' w/mud, 1/3 sx hulls below plug to 350'.
Cemented w/20 sacks cement through drill pipe. Filled
hole to 35' w/mud. Plug to 35' w/1/3 sx hulls below plug.
Filled w/cement to base of cellar.

(If additional description is necessary, use BACK of this sheet)

Name of Plugging Contractor Rupp-Ferguson Oil Co.
Address 523 Petroleum Bldg., Wichita, Kansas


STATE OF Kansas, COUNTY OF Sedgwick, ss.
L. W. Knox (employee of owner) or (owner or operator) of the above-described well, being first duly sworn on oath, says: That I have knowledge of the facts, statements, and matters herein contained and the log of the above-described well as filed and that the same are true and correct. So help me God.

(Signature) L. W. Knox
523 Petroleum Bldg., Wichita, Kansas
(Address)

SUBSCRIBED AND SWORN to before me this 10th day of June, 19 54

My commission expires 6-4-55

24-7968-S 3-53-20M

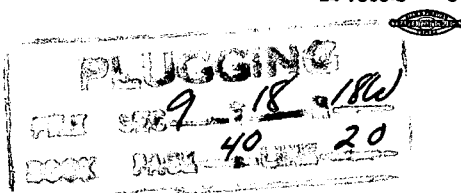

RECEIVED
STATE CORPORATION COMMISSION
Notary Public.

6-11-54
CONSERVATION DIVISION

CONTRACTOR'S WELL LOG

YOUNG #1

SE SE SE, Sec. 9-18S-18W, Rush County, Kansas

D & A

Contractor: Rupp-Ferguson Oil Co.

Elevation 2084 KB

Commenced 5-29-54

Completed 6-7-54

Figures Represent Bottom of Formation

645 shale
 880 sand
 890 shale
 900 sand
 1245 red bed
 1280 Anhydrite
 1745 shale & shells
 1950 salt
 2295 lime & shale
 2365 lime
 2600 lime & shale
 2760 shale
 2916 shale & shells
 3465 lime & shale
 3632 lime
 3684 lime & shale
 3839 lime
 3876 lime & shale
 3900 Arbuckle

Tops:

Heebner	3426 (-1342)
Toronto	3444 (-1360)
Lansing-K.C.	3479 (-1395)
Base Kansas City	3746 (-1662)
Conglomerate	3858 (-1774)
Arbuckle	3876 (-1792)
T.D.	3900 (-1816)

STATE OF KANSAS)

) SS:

SEDGWICK COUNTY)


I, L. W. Knox, Landman for Rupp-Ferguson Oil Co., do hereby certify that the above and foregoing is a true and correct copy of the log of the No. 1 Young well.

L. W. Knox
 L. W. Knox

Subscribed and sworn to before me this 10th day of June, 1954.

Helen Horine
 Notary Public

My Commission Expires: 6-4-55

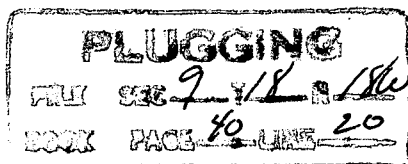

RECEIVED
 STATE CORPORATION COMMISSION

JUN 11 1954
 6-11-54
 CONSERVATION DIVISION
 Wichita, Kansas