


STATE OF KANSAS
STATE CORPORATION COMMISSION
200 Colorado Derby Bldg.
Wichita, Kansas 67202

Form CP-4
Rev. 12-15-80

WELL PLUGGING RECORD

Give All Information Completely
Make Required Affidavit

COUNTY Rush SEC. 9 TWP. 18S RGE. 18W XXX
Location as in quarters or footage from lines:
NE SE SE

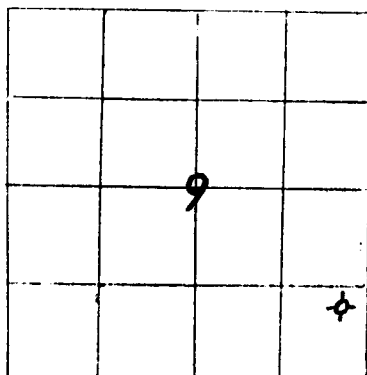

Lease Owner IREX Corp.
Lease Name Young Well No. 1
Office Address 1670 Broadway, Suite 3301, Denver, Colorado 80202
Character of Well (Completed as Oil, Gas or Dry Hole): Dry Hole
Date Well Completed June 22, 1983
Application for plugging filed June 22, 1983
Plugging commenced June 22, 1983
Plugging completed June 22, 1983
Reason for abandonment of well or producing formation No shows.

Locate Well
correctly on above
Section Platt.

Was permission obtained from the Conservation Division or it's
Agent's before plugging was commenced? Yes

Name of Conservation Agent who supervised plugging of this well Paul Luthi

Producing formation Non-applicable Depth to top -- bottom -- T.D. 3965'

Show depth and thickness of all water, oil and gas formations.

OIL, GAS OR WATER RECORDS Non-applicable Casing Record

Formation	Content	From	To	Size	Put in	Pulled Out
				8 5/8"	1258'	none

Describe in detail the manner in which the well was plugged, indicating where the mud fluid was placed and the method or methods used in introducing it into the hold. If cement or other plugs were used, state the character of same and depth placed, from 3960' feet to 40' feet for each plug set. Plug at 3960' w/40 sks.; plug at 1320' w/50 sks.; plug at 540' w/35 sks.; plug at 40' w/10 sks. 15 sks. in rat hole. Cement 150 sks. cement. 60/40 poz, 2% gel, 3% CC. Plug 2:30 A.M. 6/22/83. Release rig at 3:30 A.M. 6/22/83.

SEP 21 1983
9-21-83

(If additional description is necessary, use BACK of this sheet)

Name of Plugging Contractor Halliburton, Hays, Kansas

STATE OF Colorado COUNTY OF Denver, ss. William H. Bayliff,
Operations Manager, IREX Corp. ~~(employee of owner)~~ ~~(owner or operator)~~ of the
above-described well, being first duly sworn on oath, says: That I have knowledge of the
facts, statements, and matters herein contained and the log of the above-described well as
filed and that the same are true and correct. So help me God.

(Signature) William H. Bayliff
1670 Broadway, Suite 3301
(Address)

SUBSCRIBED AND SWORN TO before me this 15th day of September 19 83
Denver, Colorado 80202

Mary J. Warren
Notary Public.

My Commission expires: June 9, 1985