


STATE OF KANSAS
STATE CORPORATION COMMISSION

WELL PLUGGING RECORD

Give All Information Completely
Make Required Affidavit
Mail or Deliver Report to
Conservation Division
State Corporation Comm.
245 North Water
Wichita, KS 67202

Rush County. Sec. 9 Twp. 18S Rge. 18W E/W
Location as "NE/CNW $\frac{1}{2}$ SW $\frac{1}{4}$ " or footage from lines _____
SW SW SE

Lease Owner J. A. ALLISON
Lease Name Young Well No. 1
Office Address 200 W. Douglas, Wichita, Kansas 67202
Character of Well (Completed as Oil, Gas or Dry Hole) _____
Dry Hole

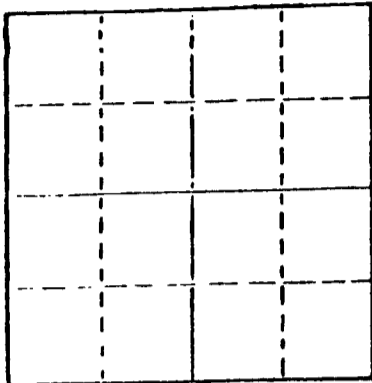

Locate well correctly on above
Section Flat

Date Well completed 3-22 1977
Application for plugging filed 3-27 1977
Application for plugging approved 3-27 1977
Plugging commenced 3-27 1977
Plugging completed 3-27 1977
Reason for abandonment of well or producing formation _____
No commercial quantities of oil or gas encountered.
If a producing well is abandoned, date of last production _____
19

Was permission obtained from the Conservation Division or
its agents before plugging was commenced? Yes

Name of Conservation Agent who supervised plugging of this well Leo Massey
Producing formation _____ Depth to top _____ Bottom _____ Total Depth of Well 3910
Show depth and thickness of all water, oil and gas formations.

OIL, GAS OR WATER RECORDS

CASING RECORD

FORMATION	CONTENT	FROM	TO	SIZE	PUT IN	PULLED OUT
Surface Hole	Shale	Surf.	1194	8-5/8"	1196	None

Describe in detail the manner in which the well was plugged, indicating where the mud fluid
was placed and the method or methods used in introducing it into the hold. If cement or other
plugs were used, state the character of same and depth placed, from _____ feet to
_____ feet for each plug set.

Fluid to 420', plug, 40 sx cement;
Fluid to 40', plug, 1/2 sx hulls, 10 sx cement;

04 05-1977

(If additional description is necessary, use BACK of this sheet)
Name of Plugging Contractor D N B DRILLING, INC.
701 First National Building
Wichita, Kansas 67202

STATE OF KANSAS COUNTY OF _____, ss.
JAMES L. DONELSON (employee of owner) or (owner or operator)
of the above-described well, being first duly sworn on oath, says: That I have knowledge of
the facts, statements, and matters herein contained and the log of the above-described well
as filed and that the same are true and correct. So help me God.

(Signature) James L. Donelson
515 R. H. Garvey Bldg., Wichita, Ks.
(Address)

SUBSCRIBED AND SWORN TO before me this 4th day of April, 19 77

Ella Priess
Notary Public.

My commission expires August 25, 1980 Ella Priess



DRILLERS' LOG

J. A. ALLISON
 No. 1 Young
 SW SW SE, Sec. 9-18S-18W
 Rush County, Kansas

Commenced: 3-21-77
 Completed: 3-27-77

Surface Casing: 1197' of 8-5/8"
 cemented w/250 sx 60-40 Posmix
 225 sx common cement, 2% Gel,
 3% cc. 3-22-77

FORMATIONDEPTH

Surface Hole	0 - 1194
Shale	1194 - 1201
Sand & Shale	1201 - 1254
Anhydrite	1254 - 1283
Sand & Shale	1283 - 1870
Shale & Lime	1870 - 2170
Lime & Shale	2170 - 2450
Shale	2450 - 2695
Lime & Shale	2695 - 3518
Lime	3518 - 3655
Lime & Shale	3655 - 3840
Lime	3840 - 3910 RTD

I do hereby certify that the foregoing statements are true and correct to the best of my knowledge and belief.

D N B DRILLING, INC.

James L. Donelson
 JAMES L. DONELSON

STATE OF KANSAS: ss:

Subscribed and sworn to before me this 4th day of April 1977.

Ella Priess
 Ella Priess, Notary Public

