


STATE OF KANSAS
STATE CORPORATION COMMISSION

WELL PLUGGING RECORD

Give All Information Completely
Make Required Affidavit
Mail or Deliver Report to
Conservation Division
State Corporation Comm.
245 North Water
Wichita, KS 67202

Barber County, Sec. 34 Twp. 30S Rge. 11W E/W
Location as "NE/CNW $\frac{1}{4}$ SW $\frac{1}{4}$ " or footage from lines
NW. NW. NE.

Lease Owner Gear Petroleum Co.
Lease Name Spriggs Well No. 1
Office Address _____
Character of Well (Completed as Oil, Gas or Dry Hole) _____
Oil

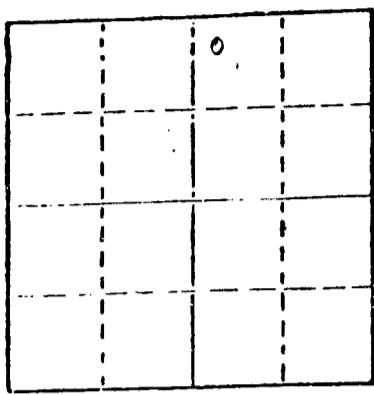

Date Well completed 8-19 19 79
Application for plugging filed 8-1- 19 79
Application for plugging approved _____ 19 ____
Plugging commenced 9-10 19 79
Plugging completed 9-17 19 79
Reason for abandonment of well or producing formation _____

If a producing well is abandoned, date of last production _____ 19 ____

Was permission obtained from the Conservation Division or its agents before plugging was commenced? Yes.

Name of Conservation Agent who supervised plugging of this well Bill Owens
Producing formation _____ Depth to top _____ Bottom _____ Total Depth of Well _____
Show depth and thickness of all water, oil and gas formations.

OIL, GAS OR WATER RECORDS

CASING RECORD

FORMATION	CONTENT	FROM	TO	SIZE	PUT IN	PULLED OUT
				8 5/8"	207	NONE
				4 1/2"	3798	3282

Describe in detail the manner in which the well was plugged, indicating where the mud fluid was placed and the method or methods used in introducing it into the hold. If cement or other plugs were used, state the character of same and depth placed, from _____ feet to _____ feet for each plug set.

Sand from 3798 to 3700
4 sacks cement from 3700 to 3660
Ripped at 3430 and 3282
Pump in 8 - sack hull
20 - sack Jell
100 - sacks 50-50 POZ 4% Jell

(If additional description is necessary, use BACK of this sheet)

Name of Plugging Contractor Clarke Corporation

STATE OF Kansas COUNTY OF Barber, ss.
Elmo R. Margenstern (employee of owner) or (owner or operator)
of the above-described well, being first duly sworn on oath, says: That I have knowledge of the facts, statements, and matters herein contained and the log of the above-described well as filed and that the same are true and correct. So help me God.

(Signature) Elmo R. Margenstern
Medicine Lodge, Mo. 67104
(Address)

SUBSCRIBED AND SWORN TO before me this 19th day of September, 1979.

Jessie Hamilton
Notary Public.

My commission expires April 4, 1982.

10-10-1979

15-007-20644-00-00

DRILLERS LOG

No. 1 Spriggs

CASING RECORD:

8 5/8" @ 207'
w/160 sx cement

4 1/2" @ 3,798'
w/100 sx cement

TOTAL DEPTH: 3,800'

COMPANY: Gear Petroleum Company

CONTRACTOR: Red Tiger Drilling Company

COMMENCED: July 31, 1978

COMPLETED: August 9, 1978

DESCRIPTION:

SPRIGGS #1

C NW/4 NW/4 NE/4

Sec. 34-T30S-R11W

Barber County, Kansas

ELEVATION:

<u>FORMATION</u>	<u>FROM</u>	<u>TO</u>	<u>REMARKS</u>
Sand & Clay	0	215	
Sand & Shale	215	1300	
Shale	1300	2380	
Shale & Lime	2380	2595	
Lime & Shale	2595	2760	
Shale	2760	2940	
Lime & Shale	2940	3605	
Lime	3605	3735	
Lime & Shale	3735	3754	
Lime	3754	3764	
Lime & Shale	3764	3800	
RTD		3800	


I certify that this is a true and correct copy of the above log to the best of my knowledge.

RED TIGER DRILLING COMPANY

Gloria Fawcett
Gloria Fawcett

Subscribed and sworn to before me this 14th day of August, 1978.

Joyce A. Hagermann
Notary Public

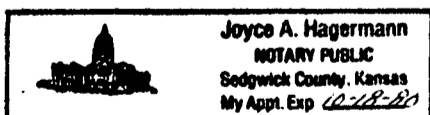

RECEIVED
STATE GEOLOGICAL COMMISSION

AUG - 8 1978
08-06-1979