


15-169-20191-0000

WELL PLUGGING RECORD

Give All Information Completely
 Make Required Affidavit

COUNTY SALINE SEC. 18 TWP. 16S RGE. 1 E/W
 Location as in quarters or footage from lines:
 SW-NW-SE

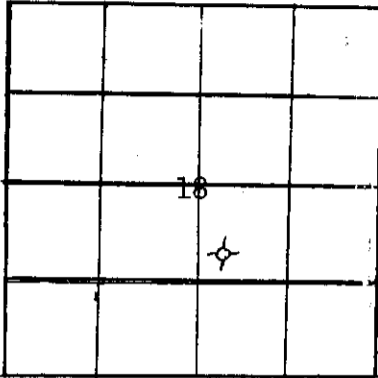

Locate Well
 correctly on above
 Section Platt.

Lease Owner L. O. Tenk
 Lease Name Holcom Well No. 1
 Office Address P.O.Box 588, Ottawa, KS. 66067
 Character of Well (Completed as Oil, Gas or Dry Hole): Dry Hole
 Date Well Completed 1-4-83
 Application for plugging filed (Verbally approved) 1-6-83
 Plugging commenced 1-4-83
 Plugging completed 1-4-83
 Reason for abandonment of well or producing formation _____

Was permission obtained from the Conservation Division or it's
 Agent's before plugging was commenced? Yes

Name of Conservation Agent who supervised plugging of this well Merlan Unruh
 Producing formation _____ Depth to top _____ bottom _____ T.D. 2719'
 Show depth and thickness of all water, oil and gas formations.

OIL, GAS OR WATER RECORDS

Casing Record

| Formation | Content | From | To | Size | Put in | Pulled Out |
|------------------------------|---------|------|------|--------|--------|------------|
| Surface Soil, Clay & Rock | Surface | 0 | 213' | 8-5/8" | 213' | None |
| | | | | | | |
| | | | | | | |

Describe in detail the manner in which the well was plugged, indicating where the mud
 fluid was placed and the method or methods used in introducing it into the hold. If cement
 or other plugs were used, state the character of same and depth placed, from _____ feet
 to _____ feet for each plug set.

60 Sacks @ 250'
10 Sacks & Bridging Plug @ 10'
10 Sacks in Rat Hole

(If additional description is necessary, use BACK of this sheet)

Name of Plugging Contractor Brandt Drilling Co., Inc.

STATE OF KANSAS COUNTY OF SEDGWICK, ss. of Brandt Drilling Co., Inc.
Timothy E. Brandt, VP & Gen. Mgr.* (employee of owner) or (owner or operator) of the
 above-described well, being first duly sworn on oath, says: That I have knowledge of the
 facts, statements, and matters herein contained and the log of the above-described well as
 filed and that the same are true and correct. So help me God.

(Signature) [Signature]
 1200 Douglas Bldg., 104 S. Broadway, Wichita, KS. 67202
 (Address)



SUBSCRIBED AND SWORN TO before me this 6th day of January, 1983

Barbara June Brandt
 Barbara June Brandt, **RECEIVED** Public.
 STATE CORPORATION COMMISSION

My Commission expires: February 28, 1984

JAN 14 1983