

15-1165-02236-0000


STATE OF KANSAS
STATE CORPORATION COMMISSION

Form CP-4

Give All Information Completely
Make Required Affidavit
Mail or Deliver Report to:
Conservation Division
State Corporation Commission
212 No. Market
Wichita, Kansas

WELL PLUGGING RECORD

RUSH County. Sec. 26 Twp. 17 Rge. 17 (E) (W)
Location as "NE/CNW/SW" or footage from lines NE SW SE
Lease Owner FRONTIER OIL CO
Lease Name ERDES Well No. 1
Office Address 1720 NICHITA PLAZA WICHITA, KANSAS
Character of Well (completed as Oil, Gas or Dry Hole) GAS
Date well completed _____ 19____
Application for plugging filed MARCH 2 1966
Application for plugging approved MARCH 2 1966
Plugging commenced MARCH 2 1966
Plugging completed MARCH 2 1966
Reason for abandonment of well or producing formation Non-economic

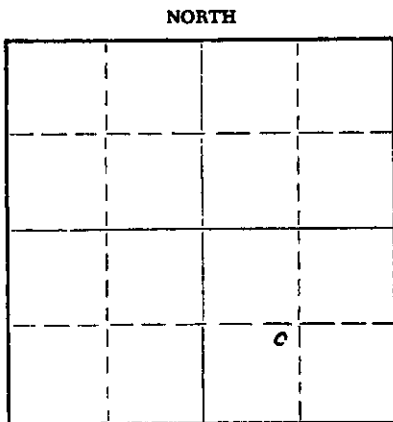

Locate well correctly on above
Section Plat

If a producing well is abandoned, date of last production _____ 19____
Was permission obtained from the Conservation Division or its agents before plugging was commenced? YES

Name of Conservation Agent who supervised plugging of this well GILBERT LEIKER
Producing formation TERRA Depth to top 3010 Bottom 3015 Total Depth of Well 3528 Feet
Show depth and thickness of all water, oil and gas formations.

OIL, GAS OR WATER RECORDS

CASING RECORD

FORMATION	CONTENT	FROM	TO	SIZE	PUT IN	PULLED OUT
	<u>8 3/4"</u>	<u>0'</u>	<u>207'</u>	<u>8 3/4"</u>	<u>207'</u>	<u>NONE</u>
		<u>0'</u>	<u>3577'</u>	<u>4 1/2"</u>	<u>3577'</u>	<u>NONE</u>

Describe in detail the manner in which the well was plugged, indicating where the mud fluid was placed and the method or methods used in introducing it into the hole. If cement or other plugs were used, state the character of same and depth placed, from 700' feet to _____ feet for each plug set.

Hole logged with approximately 70 sacks of gal mud. Mix of remaining 5 sacks of gal mud at 150 pounds pressure. Pumped plug down with 70 sacks of cement to around 700' and shut well in at 100 pounds standing pressure

RECEIVED
STATE CORPORATION COMMISSION
3-17-66
MAR 17 1966
CONSERVATION DIVISION
WICHITA, KANSAS

(If additional description is necessary, use BACK of this sheet)

Name of Plugging Contractor H. H. Hurlbert
Address Moys, Kansas

STATE OF Kansas COUNTY OF Sedgwick, ss.
Maguire V. Starr (employee of owner) or (~~owner or operator~~) of the above-described well, being first duly sworn on oath, says: That I have knowledge of the facts, statements, and matters herein contained and the log of the above-described well as filed and that the same are true and correct. So help me God.

(Signature) Maguire V. Starr
1720 Nichita Plaza - Nichita
(Address)

SUBSCRIBED AND SWORN TO before me this 16th day of March, 1966
Jean Holler
Notary Public.

My commission expires 5-22-66