

15-10-20211-0000


STATE OF KANSAS
STATE CORPORATION COMMISSION

WELL PLUGGING RECORD

Give All Information Completely
Make Required Affidavit
Mail or Deliver Report to
Conservation Division
State Corporation Comm.
245 North Water
Wichita, KS 67202

Lane _____ County, Sec. 12 Twp. 17S Rge. 29W E/W
Location as "NE/CNW/SW" or footage from lines _____
Approx. NW NW NE

Lease Owner Tomlinson Oil Co.
Lease Name Eaton Well No. #2
Office Address Suite 1030, 200 W. Douglas, Wichita, Kansas
Character of Well (Completed as Oil, Gas or Dry Hole) _____
D & A

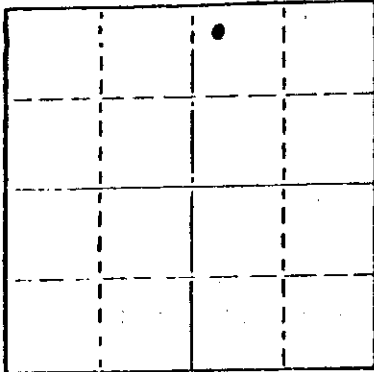

Locate well correctly on above
Section Plot

Date Well completed 2-5 1977
Application for plugging filed 2-5 1977
Application for plugging approved 2-5 1977
Plugging commenced 2-5 1977
Plugging completed 2-5 1977

Reason for abandonment of well or producing formation _____
D & A
If a producing well is abandoned, date of last production _____ 19____

Was permission obtained from the Conservation Division or
its agents before plugging was commenced? Yes

Name of Conservation Agent who supervised plugging of this well Gilbert Balthazor
Producing formation _____ Depth to top _____ Bottom _____ Total Depth of Well _____
Show depth and thickness of all water, oil and gas formations.

OIL, GAS OR WATER RECORDS

CASING RECORD

FORMATION	CONTENT	FROM	TO	SIZE	PUT IN	PULLED OUT
	Surface pipe	0	317'	8 5/8	317'	0

Describe in detail the manner in which the well was plugged, indicating where the mud fluid was placed and the method or methods used in introducing it into the hold. If cement or other plugs were used, state the character of same and depth placed, from _____ feet to _____ feet for each plug set.

- Filled hole with heavy mud.
- Bottom Plug @ 1100' with 70 sks. cement.
- #1 plug set @ 300' with 20 sks. cement.
- #2 plug set @ 40' with 10 sks. cement.
- #3 plug set in rat hole with 2 sks. cement.

FEB 10 1977
2-10-77
CONSERVATION DIVISION
WICHITA, KANSAS

(If additional description is necessary, use BACK of this sheet)

Name of Plugging Contractor Blue Goose Drilling Co., Inc.
Box 1413, Great Bend, Kansas 67530


STATE OF Kansas COUNTY OF Barton ss.
George E. Miller, Jr. (employee of owner) or (owner or operator) of the above-described well, being first duly sworn on oath, says: That I have knowledge of the facts, statements, and matters herein contained and the log of the above-described well as filed and that the same are true and correct. So help me God.

(Signature) George E. Miller, Jr.
Box 1413, Great Bend, Kansas 67530
(Address)

SUBSCRIBED AND SWORN TO before me this 8th day of February, 1977

Mary Ann Schwamborn
Notary Public.

My commission expires 7-10-77

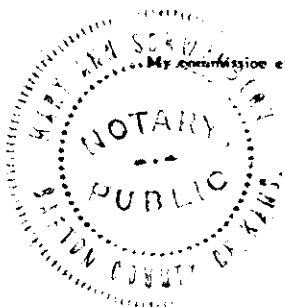

15-101-20211-0000

WELL LOG
Eaton #2
Approx. NW NW NE- 12-17S-29W
Lane County, Kansas

Name of Operator: Tomlinson Oil Co., Inc.
Suite 1030, 200 W. Douglas
Wichita, Kansas 67202

Date Completed: February 5, 1977

FROM	TO	
0	317	Sand
137	780	Shale and sand
780	2180	Shale
2180	2204	Anhydrite
2204	2475	Shale and lime
2475	2580	Shale and shells
2580	3560	Shale and lime
3560	3675	Lime
3675	3950	Shale and lime
3950	4155	Lime
4155	4242	Shale and lime
4242	4335	Lime
4335	4415	Lime and shale
4415	4465	Lime
4465	4550	Lime and shale
4550	4570	Lime
4570		Total Depth

02-10-1977

STATE OF KANSAS

COUNTY OF BARTON ss

George E. Miller, Jr., President of Blue Goose Drilling Co., Inc.
being first duly sworn on oath says: That I have knowledge of the facts, statements
and matters herein contained and the log of the above described well as filed
and that the same are true and correct.

George E. Miller, Jr.
George E. Miller, Jr.

Subscribed and sworn before me this 8th day of February, 1977.

Mary Ann Schwandoren
Notary Public Barton County

My Commission Expires 7-10-77

