

Give All Information Completely  
Make Required Affidavit  
Mail or Deliver Report to:  
Conservation Division  
State Corporation Commission  
212 North Market, Insurance Bldg.  
Wichita, Kansas

WELL PLUGGING RECORD

Ellis County, Sec. 36 Twp. 11 Rge. 19 (E) (W)

Location as "NE/CNW%SW%" or footage from lines NE SW NW

Lease Owner J. F. Darby Oil Co.

Lease Name Jensen "A" Well No. 1

Office Address 403 Philtower, Tulsa, Oklahoma

Character of Well (completed as Oil, Gas or Dry Hole) oil

Date well completed 19

Application for plugging filed June 26, 1960 19

Application for plugging approved June 26, 1960 19


Plugging commenced June 26, 1960 19

Plugging completed June 29, 1960 19

Reason for abandonment of well or producing formation dry

If a producing well is abandoned, date of last production 19

Was permission obtained from the Conservation Division or its agents before plugging was commenced? yes

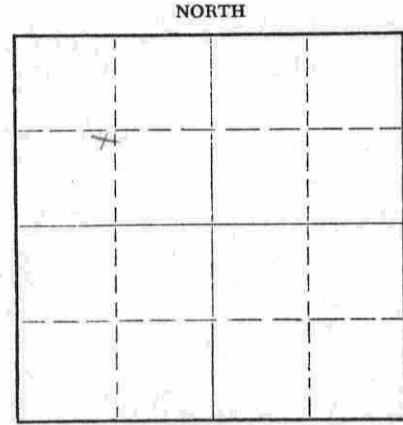

Locate well correctly on above Section Plat

Name of Conservation Agent who supervised plugging of this well Eldon Petty

Producing formation Depth to top Bottom Total Depth of Well 3668 Feet

Show depth and thickness of all water, oil and gas formations.

OIL, GAS OR WATER RECORDS

CASING RECORD

FORMATION	CONTENT	FROM	TO	SIZE	PUT IN	PULLED OUT

Describe in detail the manner in which the well was plugged, indicating where the mud fluid was placed and the method or methods used in introducing it into the hole. If cement or other plugs were used, state the character of same and depth placed, from feet to feet for each plug set.

mixed and run 4 sacks cement  
circulated hole with jell mud at 550' and spotted 20 sacks cement thru 5 1/2 casing. Pulled pipe to 170' and spotted 20 sacks cement.  
Mudded hole to 40' set 10' rock bridge and run 10 sacks cement to base of cellar.

RECEIVED  
STATE CORPORATION COMMISSION  
7-12-60  
JUL 12 1960  
CONSERVATION DIVISION  
Wichita, Kansas

(If additional description is necessary, use BACK of this sheet)

Name of Plugging Contractor Southwest Casing Pulling Co., Inc.

Address Box 364, Great Bend, Kansas

STATE OF Kansas COUNTY OF Barton, ss.  
Southwest Casing Pulling Co., Inc. (employee of owner) or (owner or operator) of the above-described

well, being first duly sworn on oath, says: That I have knowledge of the facts, statements, and matters herein contained and the log of the above-described well as filed and that the same are true and correct. So help me God.

(Signature) Roy L. Myers  
Box 364, Great Bend, Kansas  
Sec. Treas.  
(Address)

SUBSCRIBED AND SWORN TO before me this 11 day of July, 19 60

Juanita R. Myers  
Notary Public.

My commission expires December 18, 1962



JENSON "A" No. 1

J. F. Darby Oil Co.  
403 Philtower  
Tulsa, Oklahoma

NE SW NW  
36-11-19

TD 3668

$5\frac{1}{2}$  3664'  
 $8\frac{5}{8}$  180'

**RECEIVED**  
STATE COMMISSION

JUL 12 1960

**CONSERVATION DIVISION**  
Wichita, Kansas

TOPS

Anhydrite	1452
Hebner	3338
Kansas City	3375
Simpson	3648
Arbuckle	3661

"No other log available"