


STATE OF KANSAS  
STATE CORPORATION COMMISSION

Form CP-4

Give All Information Completely  
Make Required Affidavit  
Mail or Deliver Report to:  
Conservation Division  
State Corporation Commission  
212 No. Market  
Wichita, Kansas

## WELL PLUGGING RECORD

NORTH

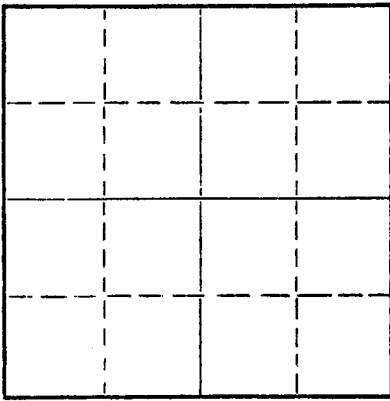

Locate well correctly on above  
Section Plat

Rush County. Sec. 33 Twp. 19 Rge. 19 (E) W (W)  
Location as "NE/CNW/SW" or footage from lines. NW NE NE  
Lease Owner H. B. Mabey Company  
Lease Name Becker Well No. 1  
Office Address Box 94718, Oklahoma City, Oklahoma 73109  
Character of Well (completed as Oil, Gas or Dry Hole) Dry Hole  
Date well completed 4-9 1969  
Application for plugging filed 4-9 1969  
Application for plugging approved 4-9 1969  
Plugging commenced 4-9 1969  
Plugging completed 4-9 1969  
Reason for abandonment of well or producing formation Dry Hole

If a producing well is abandoned, date of last production 19  
Was permission obtained from the Conservation Division or its agents before plugging was commenced? Yes

Name of Conservation Agent who supervised plugging of this well Leo Massey  
Producing formation Depth to top Bottom Total Depth of Well Feet  
Show depth and thickness of all water, oil and gas formations.

## OIL, GAS OR WATER RECORDS

## CASING RECORD

FORMATION	CONTENT	FROM	TO	SIZE	PUT IN	PULLED OUT
Surface Pipe				8 5/8"	388'	

Describe in detail the manner in which the well was plugged, indicating where the mud fluid was placed and the method or methods used in introducing it into the hole. If cement or other plugs were used, state the character of same and depth placed, from feet to feet for each plug set.

1st. plug was set @ 660' with 70 sacks cement  
2nd. plug was set @ 360' with 20 sacks cement  
3rd. plug was set @ 40' with 10 sacks cement  
Cementing to bottom of cellar

RECEIVED  
STATE CORPORATION COMMISSION  
APR 14 1969  
4-14-69  
CONSERVATION DIVISION  
Wichita, Kansas

(If additional description is necessary, use BACK of this sheet)

Name of Plugging Contractor L. J. Dreiling & Sons, Inc.  
Address Route 2, Victoria, Kansas 67671

STATE OF KANSAS, COUNTY OF ELLIS, ss.  
I, Leo F. Dreiling (employee of owner) or (owner or operator) of the above-described


well, being first duly sworn on oath, says: That I have knowledge of the facts, statements, and matters herein contained and the log of the above-described well as filed and that the same are true and correct. So help me God.

(Signature)

LEO F. DREILING, ROUTE 2, VICTORIA, KANSAS 67671

(Address)

SUBSCRIBED AND SWORN TO before me this 11th day of April, 1969

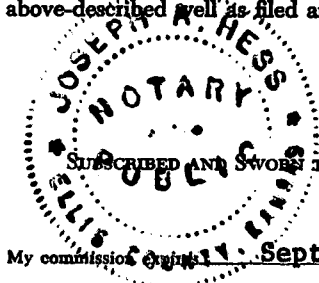

JOSEPH A. HESS

Notary Public.

# 15.165-20230-0000 L. J. DREILING AND SONS, INC.

Victoria, Kansas 67671

## WELL LOG

Company	H. B. Mabee Company Box 94718 Oklahoma City, Oklahoma 73109	Sec. 33	Twp. 19	Rng. 19
Farm	Becker No. 1	Location	NW NE NE	
Total Depth	4275'	County	Rush	
Comm.	3-31-69	Comp.	4-9-69	Elevation: 2274' K. B.
Contractor	L. J. Dreiling & Sons, Inc. Victoria, Kansas 67671			2271' D. F.
				2269' G. R.
		Casing Record	Cement Record	Production:
	388' - 8 5/8"		250 sacks cement	

Figures Indicate Bottom of Formations

0'	219'	Surface Clay & Sand
219'	835'	Shale
835'	1063'	Sand
1063'	1427'	Redbed
1427'	1482'	Anhy.
1482'	1721'	Shale
1721'	2125'	Shale & Lime
2125'	2225'	Lime
2225'	2500'	Lime & Shale Streaks
2500'	2680'	Shale & Lime
2680'	2825'	Lime
2825'	3705'	Shale & Lime
3705'	4220'	Lime
4220'	4225'	Cong. & Chert
4225'	4275'	Cong.
4275'	T.D.	

RECEIVED  
STATE CORPORATION COMMISSION  
APR 14 1969  
4-14-69  
CONSERVATION DIVISION  
Wichita, Kansas

STATE OF KANSAS)  
)ss  
COUNTY OF ELLIS)

I, Leo F. Dreiling, of the L. J. Dreiling & Sons, Inc, upon oath states that the above and foregoing is a true and correct copy from the Daily Drilling Report from your Becker #1.

*Leo F. Dreiling*  
\_\_\_\_\_  
LEO F. DREILING

Subscribed and sworn to before me this 11th day of April 1969.

*Joseph A. Hess*  
\_\_\_\_\_  
JOSEPH A. HESS NOTARY PUBLIC

My commission expires: September 19, 1970

