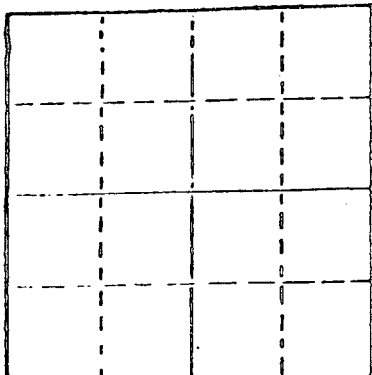


STATE OF KANSAS
STATE CORPORATION COMMISSION

WELL PLUGGING RECORD

Give All Information Completely
Make Required Affidavit
Mail or Deliver Report to
Conservation Division
State Corporation Comm.
245 North Water
Wichita, KS 67202

Locate well correctly on above
Section Plot

Rush County. Sec. 19 Twp. 19SRge. 20WXXN
Location as "NE/CNW1SW1" or footage from lines
NE NE NE
Lease Owner Pate-Dombaugh Petroleum
Lease Name Pirner Well No. 1
Office Address 502 Union Center, Wichita, Kansas 67202
Character of Well (Completed as Oil, Gas or Dry Hole)
Dry Hole
Date Well completed October 16, 1977
Application for plugging filed Verbal Application 1977
Application for plugging approved Verbal Approval 1977
Plugging commenced October 16, 1977
Plugging completed October 16, 1977
Reason for abandonment of well or producing formation

If a producing well is abandoned, date of last production
19

Was permission obtained from the Conservation Division or
its agents before plugging was commenced? Yes

Name of Conservation Agent who supervised plugging of this well Leo Massey
Producing formation Depth to top Bottom Total Depth of Well 4495'
Show depth and thickness of all water, oil and gas formations.

OIL, GAS OR WATER RECORDS

CASING RECORD

FORMATION	CONTENT	FROM	TO	SIZE	PUT IN	PULLED OUT
	STATE CORPORATION COMMISSION			8-5/8"	340'	None
	OCT 20 1977					
	10-20-77					

Describe in detail the manner in which the well was plugged, indicating where the mud fluid was placed and the method or methods used in introducing it into the hold. If cement or other plugs were used, state the character of same and depth placed, from feet to feet for each plug set.

Filled hole with heavy rotary mud from 4495 ft. (Rotary total depth) to 550 ft. Set plug at 550 ft. and cemented with 70 sacks cement. Filled hole with heavy rotary mud from 550 ft. to 240 ft. Set plug at 240 ft. and cemented with 20 sacks cement. Filled hole with heavy rotary mud from 240 ft. to 40 ft. Set solid plug at 40 ft. and cemented to cellar with 10 sacks cement, 2 sacks cement in rat hole.

Plugging operations accomplished utilizing Halliburton Oil Well Cementing pump truck through 4-1/2 inch drill pipe.

(If additional description is necessary, use BACK of this sheet)

Name of Plugging Contractor Halliburton Services
410 Union Center, Wichita, Kansas 67202

STATE OF Kansas COUNTY OF Sedgwick, ss.
Dean Britting, Agent (employee of owner) XXXXXXXXXXXXXXXXXXXX
of the above-described well, being first duly sworn on oath, says: That I have knowledge of the facts, statements, and matters herein contained and the log of the above-described well as filed and that the same are true and correct. So help me God.

(Signature)

200 No. Main, Wichita, Kansas 67202
(Address)

SUBSCRIBED AND SWORN TO before me this 19th day of October, 1977

Elsie Willison - Notary Public.

My commission expires June 30, 1978

KANSAS GEOLOGICAL SOCIETY API # 15-165-20,657-0000
KANSAS WELL LOG BUREAU - KANSAS WELL SAMPLE BUREAU
KANSAS GEOLOGICAL SOCIETY BUILDING
508 EAST MURDOCK - WICHITA, KANSAS

COMPANY **Pate-Dombaugh Petroleum**

SEC. 19 T. 19S. R. 20W
LOC. NE NE NE

FARM **Firner**

NO. 1

COUNTY **Rush**

TOTAL DEPTH **4495'**

COMM. **October 7, 1977**

COMP. **October 16, 1977**

SHOT OR TREATED

CONTRACTOR **H-30, Inc.**

ISSUED **October 19, 1977**

KANSAS

CASING

20

10

15

8

12

6

13

5

-5/8" 340' cemented w/225 sxs cement

ELEVATION **2309 KB**

PRODUCTION

FIGURES INDICATE BOTTOM OF FORMATIONS

Shale	1531'
Anhydrite	1575'
Shale	2215'
Shale and Lime	2370'
Lime and Shale	4020'
Lime	4495'
Rotary Total Depth	4495'

RECEIVED
STATE CORPORATION COMMISSION

OCT 20 1977
10-20-77
CONSERVATION DIVISION
Wichita, Kansas


I hereby certify the above and foregoing to be
a true and correct log of the above described
well as shown by the drilling reports.

H-30, INC.

Dean Britting

State of Kansas }
County of Sedgwick } ss:

Subscribed and Sworn to before me a Notary Public in
and for said county and state this 19th. day of
October, 1977.

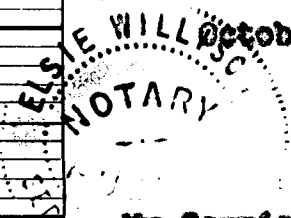

Elsie Willison
Elsie Willison - Notary Public

My Commission Expires:
June 30, 1978