


STATE OF KANSAS
STATE CORPORATION COMMISSION
200 Colorado Derby Bldg.
Wichita, Kansas 67202

Form CP-4
Rev. 12-15-80

WELL PLUGGING RECORD

Give All Information Completely
Make Required Affidavit

COUNTY Rush SEC. 6 TWP. 19S RGE. 20 E/W
Location as in quarters or footage from lines:
2310' FSL 2310' FEL of NE $\frac{1}{4}$

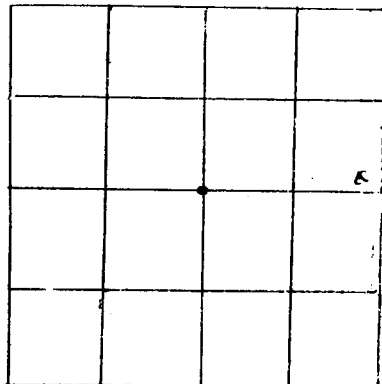

Locate Well
correctly on above
Section Platt.

Lease Owner Bankoff Oil Company
Lease Name Bromlow "B" Well No. 1
Office Address 6202 S. Lewis, Suite 176, Box 3446, Tulsa, OK 74101
Character of Well (Completed as Oil, Gas or Dry Hole): Dry Hole
Date Well Completed 4-23-83
Application for plugging filed yes
Plugging commenced 4-23-83
Plugging completed 4-23-83
Reason for abandonment of well or producing formation Dry Hole

Was permission obtained from the Conservation Division or it's
Agent's before plugging was commenced? yes

Name of Conservation Agent who supervised plugging of this well Paul Luthi
Producing formation _____ Depth to top _____ bottom _____ T.D. 4,340'
Show depth and thickness of all water, oil and gas formations.

OIL, GAS OR WATER RECORDS

Casing Record

Formation	Content	From	To	Size	Put in	Pulled Out
				8-5/8"	359'	

Describe in detail the manner in which the well was plugged, indicating where the mud fluid was placed and the method or methods used in introducing it into the hold. If cement or other plugs were used, state the character of same and depth placed, from _____ feet to _____ feet for each plug set.

Mud to 1470' hull plug, 50 sacks cement. Mud to 680' hull plug, 40 sacks cement.
Mud to 40' hull plug, 10 sacks cement.

(If additional description is necessary, use BACK of this sheet)

Name of Plugging Contractor Glacier Drilling Company, Inc.

STATE OF OKLAHOMA COUNTY OF TULSA, ss.

Julius M. Bankoff (employee of owner) or (owner or operator) of the
above-described well, being first duly sworn on oath, says: That I have knowledge of the
facts, statements, and matters herein contained and the log of the above-described well as
filed and that the same are true and correct. So help me God.

(Signature) Julius M. Bankoff

Box 3446, Tulsa, OK 74101
(Address)

SUBSCRIBED AND SWORN TO before me this 9th day of May, 19 83

Verna Doty
VERNA DOTY Notary Public.
STATE CORPORATION COMMISSION

My Commission expires: February 5, 1985

MAY 11 1983
5-11-83
CONSERVATION DIVISION
Wichita, Kansas

S. 6 T. 19 S. R. 20 ^E~~XXX~~

Loc. SW SW NE

County Rush

640 Acres
N

Locate well correctly

Elev.: Gr. 2,170'

DF _____ KB _____

Report of all strings set—surface, intermediate, production, etc.

Purpose of string	Size hole drilled	Size casing set (in O.D.)	Weight lbs/ft.	Setting depth	Type cement	Sacks	Type and percent additives
SURFACE	12-1/4"	8-5/8"	20#	359'	60-40 Poz	215	3% cc, 2% gel
PRODUCTION							

Show all important zones of porosity and contents thereof; cored intervals, and all drill-stem tests, including depth interval tested, cushion used, time tool open, flowing and shut-in pressures, and recoveries.

[illegible]

RECEIVED
STATE CORPORATION COMMISSION

MAY 11 1983
5-11-83
CONSERVATION DIVISION
Wichita, Kansas