


15-165-30083-0000

WELL PLUGGING RECORD

Give All Information Completely
Make Required Affidavit
Mail or Deliver Report to:
Conservation Division
State Corporation Commission
211 No. Broadway
Wichita, Kansas

NORTH

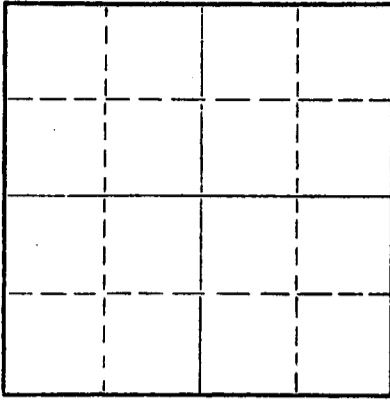

Locate well correctly on above
Section Plat

Rush County. Sec. 7 Twp. 19S Rge. 20W (E) (W)
Location as "NE/CNW/SW" or footage from lines NE NE NW
Lease Owner Leben & Bankoff
Lease Name Schlegel Well No. 1
Office Address Box 486, Great Bend, Kansas 67530
Character of Well (completed as Oil, Gas or Dry Hole) Dry Hole
Date well completed 11-29-65 19
Application for plugging filed 11-29-65 19
Application for plugging approved 11-29-65 19
Plugging commenced 11-29-65 19
Plugging completed 11-29-65 19
Reason for abandonment of well or producing formation Dry Hole

If a producing well is abandoned, date of last production 19
Was permission obtained from the Conservation Division or its agents before plugging was commenced? yes

Name of Conservation Agent who supervised plugging of this well Gilbert Leiker, Victoria, Kansas
Producing formation _____ Depth to top _____ Bottom _____ Total Depth of Well 4376 Feet
Show depth and thickness of all water, oil and gas formations.

OIL, GAS OR WATER RECORDS

CASING RECORD

FORMATION	CONTENT	FROM	TO	SIZE	PUT IN	PULLED OUT
				8 5/8"	221'	none

Describe in detail the manner in which the well was plugged, indicating where the mud fluid was placed and the method or methods used in introducing it into the hole. If cement or other plugs were used, state the character of same and depth placed, from _____ feet to _____ feet for each plug set.

Mud to 540', plug, 20 sacks cement through drill pipe
Mud to 210', plug, 20 sacks cement through drill pipe
Mud to 40', plug, 1/2 sk hulls, 10 sacks cement

RECEIVED
STATE CORPORATION COMMISSION
DEC - 6 1965
12-6-65
CONSERVATION DIVISION
WICHITA, KANSAS

(If additional description is necessary, use BACK of this sheet)

Name of Plugging Contractor Leben Drilling, Inc.
Address P. O. Box 486, Great Bend, Kansas 67530

STATE OF KANSAS, COUNTY OF BARTON, ss.
Leslie Kite (employee of owner) or (owner or operator) of the above-described well, being first duly sworn on oath, says: That I have knowledge of the facts, statements, and matters herein contained and the log of the above-described well as filed and that the same are true and correct. So help me God.

(Signature) Leslie Kite
P. O. Box 486, Great Bend, Kansas
(Address)

SUBSCRIBED AND SWORN to before me this 2nd day of December, 19 65

My commission expires April 1, 1967

Ulanda Nichols
Notary Public.

DRILLER'S LOG

COMPANY: Leben & Bankoff
 CONTRACTOR: LEBEN DRILLING, INC.
 FARM: SCHLEGEL #1
 LOCATION: NE NE NW Sec. 7-19S-20W
 RUSH COUNTY, KANSAS
 COMMENCED: 11-19-65
 COMPLETED: 11-29-65

0	221	Subsoil
221	415	Shale
415	545	Sand
545	860	Shale, Redbed
860	1410	Sand
1410	1452	Red Rock Sand
1452	1485	Anhydrite
1485	2130	Shale, Shells
2130	2293	Shale, Lime
2293	2676	Lime
2676	2769	Shale, Lime
2769	3212	Lime, Shale
3212	3488	Shale, Lime
3488	3588	Lime
3588	3791	Lime, Shale
3791	4376	Lime
	<u>4376</u>	<u>RTD - D. & A.</u>

RECORDED
 DEC - 6 1965
 12-6-65
 COUNTY OF BARTON, KANSAS

Set 8 5/8" used surface casing @ 221' with landing joint cemented with 165 sacks 60-40 Posmix Sunset 2% Gel

I, Leslie Kite, do hereby certify that the above and foregoing is a true and correct copy of the log of the Schlegel #1 well, located NE NE NW of Section 7, Township 19 South, Range 20 West, Rush County, Kansas, as reflected by the records of Leben Drilling, Inc.

Leslie Kite
 Leslie Kite

STATE OF KANSAS)
) SS
 COUNTY OF BARTON)

Subscribed and sworn to before me, a Notary Public, in and for Barton County, Kansas, this 2nd day of December, 1965.

Ulanda Nichols
 Ulanda Nichols

My Commission Expires:
 April 1, 1967