


STATE OF KANSAS
STATE CORPORATION COMMISSION

WELL PLUGGING RECORD.

Give All Information Completely
Make Required Affidavit
Mail or Deliver Report to
Conservation Division
State Corporation Comm.
245 North Water
Wichita, KS 67202

Rush County. Sec. 10 Twp. 19S Rge. 20W ~~XXXX~~
Location as "NE/CNW 1/4 SW 1/4" or footage from lines
100'S of S/2 SW NW
Lease Owner Alpine Drilling Co., Inc.
Lease Name Yost Well No. 1
Office Address 800 Bitting Bldg., Wichita, KS 67202
Character of Well (Completed as Oil, Gas or Dry Hole)
dry hole
Date Well completed November 7 1979
Application for plugging filed November 7 1979
Application for plugging approved November 7 1979
Plugging commenced November 7 1979
Plugging completed November 7 1979
Reason for abandonment of well or producing formation

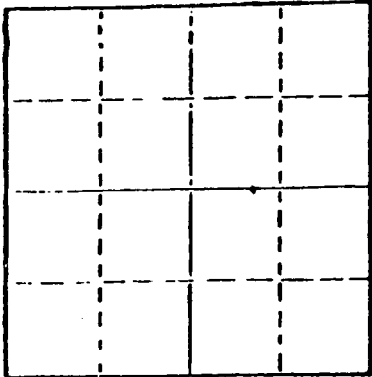

Locate well correctly on above
Section Plat

If a producing well is abandoned, date of last production 19

Was permission obtained from the Conservation Division or
its agents before plugging was commenced? yes

Name of Conservation Agent who supervised plugging of this well Marion Schmidt, Hays, Kansas
Producing formation Depth to top Bottom Total Depth of Well 4376
Show depth and thickness of all water, oil and gas formations.

OIL, GAS OR WATER RECORDS

CASING RECORD

FORMATION	CONTENT	FROM	TO	SIZE	PUT IN	PULLED OUT

Describe in detail the manner in which the well was plugged, indicating where the mud fluid was placed and the method or methods used in introducing it into the hold. If cement or other plugs were used, state the character of same and depth placed, from feet to feet for each plug set.

Plugged as follows:

Filled hole w/mud; pumped 70 sx 50/50 pozmix 4% gel thru open end D.P. @ 685'; mud to 420'; pumped 20 sx thru D.P., mud to 40', 1/2 sx hulls & wood plug for solid bridge, pumped 10 sx to base of cellar, 5 sx in rathole, completed @ 9:15 a.m. by Allied.

Witnessed: Marion Schmidt, State Plugger, Hays, Kansas
Gary Bagby, Sterling, Kansas

(If additional description is necessary, use BACK of this sheet)

Name of Plugging Contractor Husky Drilling Co., Inc.

STATE OF KANSAS COUNTY OF SEDGWICK, ss.
Jon T. Williams, Jr. (employee of owner) or (owner or operator)
of the above-described well, being first duly sworn on oath, says: That I have knowledge of the facts, statements, and matters herein contained and the log of the above-described well as filed and that the same are true and correct. So help me God.


(Signature)

800 Bitting Bldg., Wichita, KS 67202
(Address)

SUBSCRIBED AND SWORN TO before me this 9th day of November, 19 79

Geraldine Stewart
Geraldine Stewart Notary Public.

My commission expires January 12, 1981

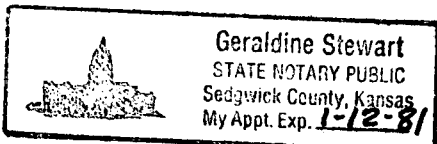

15-165-20738-0000



800 Bitting Bldg
Wichita, Kansas 67202
Phone 316 - 263-7904
Mobile Phone 316 - 793-7859 Unit 7070

November 7, 1979

WELL LOG-----Yost No. 1
Located: 100'S of S2 SW NW of Sec. 10-19S-20W
Rush County, Kansas

OWNER: Alpine Drilling Co., Inc.
ROTARY CONTRACTOR: Husky Drilling Co., Inc.

COMMENCED: November 1, 1979
COMPLETED: November 7, 1979

Rotary Total Depth: 4373'

LOG

CASING RECORD

0 - 432 Soil, clay & post rock
432 - 543 Shale & Red Bed
543 - 830 Shale & shells
830 - 1050 Sand
1050 - 1425 Shale & shells
1425 - 1457 Anhydrite
1457 - 1995 Shale & shells
1995 - 4347 Shale & lime
4347 - 4373 Lime

Ran 9 jts., 8-5/8", 28#, 8V, Rge 3,
used csg., tallied 422.27', set @ 429'
KB w/250 sx common, 2% gel, 3% cc,
circulated - plug down @ 1 a.m. 11-2-79
by Allied.

Plugged & Abandoned 11-7-79 @ 9:15 a.m.
by Allied.

11-13-79