


15-165-01855-0000

STATE OF KANSAS
STATE CORPORATION COMMISSION

Give All Information Completely
Make Required Affidavit
Mail or Deliver Report to:
Conservation Division
State Corporation Commission
211 No. Broadway
Wichita, Kansas

WELL PLUGGING RECORD

NORTH

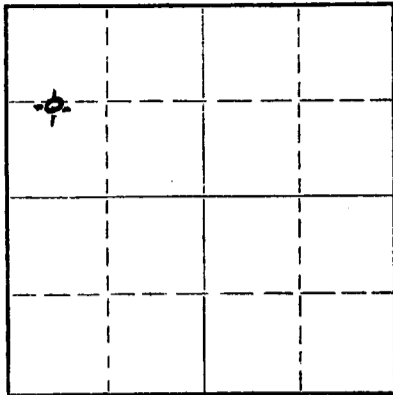

Locate well correctly on above
Section Plat

Rush County, Sec. 10 Twp. 19S Rge. 20 (E) W (W)

Location as "NE/CNW/SW" or footage from lines C W/2 NW/4
Lease Owner Walters Drilling Co.
Lease Name Yost Well No. 1
Office Address 510 Orpheum Building, Wichita, Kansas
Character of Well (completed as Oil, Gas or Dry Hole) Dry Hole
Date well completed September 27th 1961
Application for plugging filed September 27th 1961
Application for plugging approved September 27th 1961
Plugging commenced September 28th 1961
Plugging completed September 28th 1961
Reason for abandonment of well or producing formation _____

If a producing well is abandoned, date of last production _____ 19____
Was permission obtained from the Conservation Division or its agents before plugging was commenced? Yes, Verbal Approval

Name of Conservation Agent who supervised plugging of this well ~~FRANK B. BUCKLEY~~ Eldon Petty
Producing formation Cherokee Sand Depth to top _____ Bottom _____ Total Depth of Well 4265 Feet
Show depth and thickness of all water, oil and gas formations.

OIL, GAS OR WATER RECORDS

CASING RECORD

FORMATION	CONTENT	FROM	TO	SIZE	PUT IN	PULLED OUT
				8-5/8"	520'	-0-

Describe in detail the manner in which the well was plugged, indicating where the mud fluid was placed and the method or methods used in introducing it into the hole. If cement or other plugs were used, state the character of same and depth placed, from _____ feet to _____ feet for each plug set.

Set Bottom Plug @ 530 ft. with 25 sacks cement
Set Top Plug @ 40' with 10 sacks cement

RECEIVED
STATE CORPORATION COMMISSION
OCT 3 1961
10-3-61
CONSERVATION DIVISION
Wichita, Kansas

(If additional description is necessary, use BACK of this sheet)

Name of Plugging Contractor Walters Drilling Co.
Address 510 Orpheum Building, Wichita, Kansas

STATE OF KANSAS, COUNTY OF Sedgwick, ss.
Robert F. Walters (employee of owner) or (owner or operator) of the above-described well, being first duly sworn on oath, says: That I have knowledge of the facts, statements, and matters herein contained and the log of the above-described well as filed and that the same are true and correct. So help me God.

(Signature) Robert F. Walters
ROBERT F. WALTERS, Partner
510 Orpheum Building, Wichita, Kansas
(Address)

SUBSCRIBED AND SWORN TO before me this 2nd day of October, 19 61

My commission expires January 4th, 1964

R. L. Abel
R. L. Abel Notary Public.



15-165 01855-0000

YOST #1

LOCATION:	C W/2 NW/4 Section 10-19S-20W Rush County, Kansas	ELEVATION 2199 GL 2201 DF 2204 KB
OPERATOR:	James W. Hershberger & Walters Drilling Co.	DATE SPUDDED: 9/18/61
CONTRACTOR:	Walters Drilling Co.	ROTARY COMPLETION: 9/28/61
SURFACE CASING	8-5/8" set @ 520' w/275 sacks cement	
OIL STRING:	None	

L O G
(Figures indicate bottom of formation)

Soil & Clay	0-65'
Sand	75'
Shale	315'
Sand	355'
Shale	521'
Shale & Shells	675'
Shale	845'
Sand	1055'
Shale	1439'
Anhydrite	1465'
Shale	2220'
Lime	2740'
Lime & Shale	3380'
Lime	3465'
Lime & Shale	3835'
Lime	3965'
Lime & Shale	4221'
Sand	4227'
Sand & Shale	4265'
Total Depth	4265'

RECEIVED
STATE OF KANSAS COMMISSION

OCT 3 1961
10-3-61
CONCORDANCE DIVISION
WALTERS DRILLING CO.

The undersigned, Robert F. Walters, hereby certifies that the above log is a true and correct log of the formations encountered in drilling the above noted well as reflected by the Daily Drilling Reports.

WALTERS DRILLING CO.

by Robert F. Walters
ROBERT F. WALTERS, Partner

Subscribed and sworn to before me
this 2nd day of October, 1961

R. L. Abel
R. L. Abel, Notary Public

My commission expires January 4th, 1964