


STATE OF KANSAS  
STATE CORPORATION COMMISSION

WELL PLUGGING RECORD

Give All Information Completely  
Make Required Affidavit  
Mail or Deliver Report to  
Conservation Division  
State Corporation Comm.  
245 North Water  
Wichita, KS 67202

RUSH County. Sec. 10 Twp. 19S Rge. 20 E/W  
Location as "NE/CNW $\frac{1}{4}$ SW $\frac{1}{4}$ " or footage from lines  
NE NW SE  
Lease Owner Gabbert-Jones, Inc.  
Lease Name Lyda-Webb Well No. 1  
Office Address 830 Sutton Place, Wichita, Ks. 67202  
Character of Well (Completed as Oil, Gas or Dry Hole) Dry hole

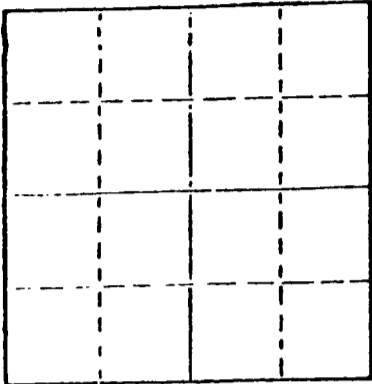

Locate well correctly on above  
Section Plat

Date Well completed April 13 1977  
Application for plugging filed April 13 1977  
Application for plugging approved April 13 1977  
Plugging commenced April 13 1977  
Plugging completed April 13 1977  
Reason for abandonment of well or producing formation Dry hole

If a producing well is abandoned, date of last production 19

Was permission obtained from the Conservation Division or its agents before plugging was commenced? yes

Name of Conservation Agent who supervised plugging of this well Leo Massey  
Producing formation \_\_\_\_\_ Depth to top \_\_\_\_\_ Bottom \_\_\_\_\_ Total Depth of Well 4200  
Show depth and thickness of all water, oil and gas formations.

OIL, GAS OR WATER RECORDS

CASING RECORD

FORMATION	CONTENT	FROM	TO	SIZE	PUT IN	PULLED OUT
Surface clay, post rock, shale & sand		0	265	8 5/8	265	0

Describe in detail the manner in which the well was plugged, indicating where the mud fluid was placed and the method or methods used in introducing it into the hold. If cement or other plugs were used, state the character of same and depth placed, from \_\_\_\_\_ feet to \_\_\_\_\_ feet for each plug set.

1st plug - 900' w/50 sx  
2nd Plug - 265' w/30 sxs  
Solid bridge plug @ 40' w/10 sx, 5 sks - rat hole  
Job complete at 1:15 AM 4/13/77

RECEIVED  
STATE CORPORATION COMMISSION  
MAY 02 1977  
52-77  
CONSERVATION DIVISION  
Wichita, Kansas

(If additional description is necessary, use BACK of this sheet)


Name of Plugging Contractor GABBERT-JONES, INC.

STATE OF Kansas COUNTY OF Sedgwick, ss.  
GABBERT-JONES, INC. - Jack W. Gabbert (owner or operator)  
of the above-described well, being first duly sworn on oath, says: That I have knowledge of the facts, statements, and matters herein contained and the log of the above-described well as filed and that the same are true and correct. So help me God.

(Signature) Jack W. Gabbert  
Jack W. Gabbert- 830 Sutton Place, Wichita  
(Address)

SUBSCRIBED AND SWORN TO before me this 29 day of April, 1977

My commission expires Nov. 29, 1979  
Marjorie Hall Notary Public.

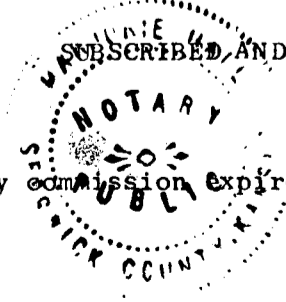

GABBERT-JONES, INC.  
 WICHITA, KANSAS  
 DRILLERS' WELL LOG

Lyda-Webb #1  
 NE-NW-SE Sec 10-19S-20W  
 Rush County Kansas

Commenced: 4-5-77

Completed: 4-13-77

OPERATOR: GABBERT-JONES, INC.

Depth	Formation	Remarks
From to		
0 100	Surface Clay-Post Rock	Ran 7 jts of 28# 8 5/8" csg
100 815	Shale-Sand	set @ 265' Cemented 2/180 sks
815 1010	Sand	Common 2% Gel - 3% CC
1010 1386	Shale-Redbed	PD @ 11:10 p.m. 4-5-77
1386 1416	Anhy	
1416 1945	Shale-Shells	
1945 2351	Shale-Lime	
2351 4129	Lime-Shale	
4129 4200	Lime	
4200 - TD		DRY & ABANDONED

STATE OF KANSAS )  
 ) SS  
 COUNTY OF SEDGWICK)

I, the undersigned, being duly sworn on oath, state that the above  
 Drillers' Well Log is true and correct to the best of my knowledge and belief and  
 according to the records of this office.

GABBERT-JONES, INC.

*James S. Sutton II*  
 JAMES S. SUTTON II

Subscribed and sworn to before me this 28th day of April, 1977.

*Elizabeth J. Edwards*  
 ELIZABETH J. EDWARDS-NOTARY PUBLIC

My Commission expires February 6, 1979.

RECEIVED  
 STATE CORPORATION COMMISSION

MAY 02 1977  
 5-2-77  
 CONSERVATION DIVISION  
 Wichita, Kansas

