


WELL PLUGGING RECORD

Give All Information Completely
Make Required Affidavit
Mail or Deliver Report to:
Conservation Division
State Corporation Commission
211 No. Broadway
Wichita, Kansas

Wichita County. Sec. 27 Twp. 20S Rge. 35W (W)
Location as "NE/CNW&SW&" or footage from lines C NE SE
Lease Owner Cleary Petroleum, Inc.
Lease Name Kunkel Well No. 1
Office Address 310 Kernac Building, Oklahoma City, Oklahoma
Character of Well (completed as Oil, Gas or Dry Hole) Dry Hole
Date well completed September 20, 19 64
Application for plugging filed September 20, 19 64
Application for plugging approved September 20, 19 64
Plugging commenced September 20, 19 64
Plugging completed September 20, 19 64
Reason for abandonment of well or producing formation Dry Hole

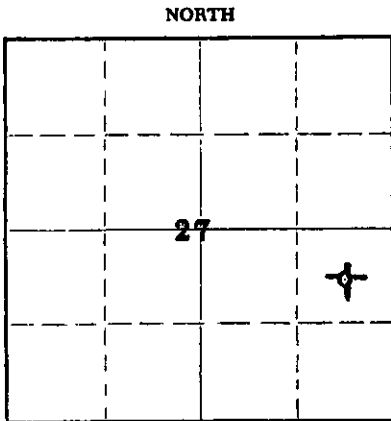

Locate well correctly on above
Section Plat

If a producing well is abandoned, date of last production _____ 19____
Was permission obtained from the Conservation Division or its agents before plugging was commenced? Yes

Name of Conservation Agent who supervised plugging of this well W. L. Nichols
Producing formation _____ Depth to top _____ Bottom _____ Total Depth of Well 5120 Feet
Show depth and thickness of all water, oil and gas formations.

OIL, GAS OR WATER RECORDS				CASING RECORD		
FORMATION	CONTENT	FROM	TO	SIZE	PUT IN	PULLED OUT
		Surface	294'	8-5/8"	294'	None

Describe in detail the manner in which the well was plugged, indicating where the mud fluid was placed and the method or methods used in introducing it into the hole. If cement or other plugs were used, state the character of same and depth placed, from _____ feet to _____ feet for each plug set.

Hole filled with mud 5120-550'
Plug 550-546'
20 sacks Cement 546-280'
Plug 280-276'
20 sacks Cement 276- 40'
Plug 40- 36'
10 sacks Cement 36- 6' Bottom of cellar.

RECEIVED
STATE CORPORATION COMMISSION
SEP 28 1964
7-28-64
CONSERVATION DIVISION
Wichita, Kansas

(If additional description is necessary, use BACK of this sheet)
Name of Plugging Contractor Halliburton Cementing Co.
Address Pratt, Kansas

STATE OF KANSAS, COUNTY OF SEDGWICK, ss.
John H. Knightley (employee of owner) of the above-described well, being first duly sworn on oath, says: That I have knowledge of the facts, statements, and matters herein contained and the log of the above-described well as filed and that the same are true and correct. So help me God.

(Signature) John H. Knightley
John H. Knightley
301 S. Broadway, Wichita, Kansas

SUBSCRIBED AND SWORN TO before me this 24th day of September, 19 64

My commission expires March 12, 1967

Stacy Lipe
Notary Public.

15-203-00032-0000

Cleary Petroleum, Inc.

Kunkel #1

C NE SE Sec. 27-20S-35W
Wichita County, Kansas

Commenced: August 29, 1964
Completed: September 20, 1964

Rotary Drilling Contractor: Lauck Drilling Company, Incorporated.

Casing Record: 294' 8-5/8" Cemented with 225 sacks Common Cement,
3% HA5.

Elevation: 3157 GL; 3160 DF; 3162 KB.

Drillers Log

Clay & Sand	180
Shale & Lime Streaks	240
Blue Shale	293
Shale	430
Shale & Shells	1420
Shale & Shell Salt	1889
Red Bed, Shale & Shells	2135
Red Bed, Shale & Shells	2260
Lime	2280
Shale & Shells	2635
Lime	3020
Lime & Shale	3130
Lime	4492
Shale & Lime	4525
Lime	4685
Lime & Shale	4730
Lime	4861
Lime & Shale	4920
Lime	4995
Chert	5072
Lime w/Chert	5088
Lime & Chert	5120 RTD

RECEIVED
STATE CORPORATION COMMISSION

SEP 28 1964

CONSERVATION DIVISION
Wichita, Kansas

I hereby certify that this is a true and correct
log of the above mentioned well, to the best
of my knowledge and belief.

John H. Knightley
Subscribed and sworn to before me this

24th day of September 1964

Stella J. Lips
Notary Public

My commission expires 3-12-67