


Give All Information Completely
Make Required Affidavit
Mail or Deliver Report to:
Conservation Division
State Corporation Commission
211 No. Broadway
Wichita, Kansas

WELL PLUGGING RECORD

Harper County, Sec. 21 Twp. 31S Rge. 7 (W)

Location as "NE/CNW/SW" or footage from lines W 1/2 / W 1/2 / SW
Lease Owner Bachus Oil Company
Lease Name Titus Well No. A-1
Office Address 721 E. Central, Wichita, Kansas
Character of Well (completed as Oil, Gas or Dry Hole) dry hole
Date well completed _____ 19____
Application for plugging filed 10-19-64 19____
Application for plugging approved 10-21-64 19____
Plugging commenced 10-22-64 19____
Plugging completed 10-25-64 19____
Reason for abandonment of well or producing formation depleted

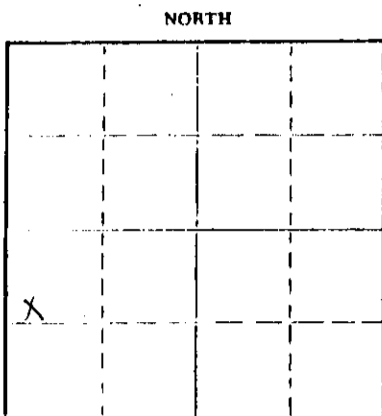

Locate well correctly on above
Section Plat

If a producing well is abandoned, date of last production _____ 19____
Was permission obtained from the Conservation Division or its agents before plugging was commenced? yes

Name of Conservation Agent who supervised plugging of this well Herman Justice
Producing formation _____ Depth to top _____ Bottom _____ Total Depth of Well 4711 Feet
Show depth and thickness of all water, oil and gas formations.

OIL, GAS OR WATER RECORDS

CASING RECORD

FORMATION	CONTENT	FROM	TO	SIZE	PUT IN	PULLED OUT
				8 5/8	258	none
				5 1/2	4709	3710.70

Describe in detail the manner in which the well was plugged, indicating where the mud fluid was placed and the method or methods used in introducing it into the hole. If cement or other plugs were used, state the character of same and depth placed, from _____ feet to _____ feet for each plug set.

Fill hole with chat from 4400' to 4330' and dump 5 sacks of cement.
Pull 5 1/2" pipe. Fill hole with mud to 250'. Set 20' rock bridge at 250' and dump 30 sacks of cement. Mud hole to 40', set 10' rock bridge and dump 10 sacks of cement to surface.

RECEIVED
STATE CORPORATION COMMISSION

OCT 28 1964

CONSERVATION DIVISION
Wichita, Kansas

Name of Plugging Contractor Flint Engineering & Construction Co.
Address Box 950, El Dorado, Kansas

STATE OF KANSAS COUNTY OF BUTLER, ss.

_____, (employee of owner) or (owner or operator) of the above-described well, being first duly sworn on oath, says: That I have knowledge of the facts, statements, and matters herein contained and the log of the above-described well as filed and that the same are true and correct. So help me God.

(Signature) [Signature]
El Dorado, Kansas

Subscribed and Sworn to before me this 26th day of October, 19 64

[Signature]
Notary Public.