


WELL PLUGGING RECORD

Give All Information Completely
Make Required Affidavit
Mail or Deliver Report to:
Conservation Division
State Corporation Commission
211 No. Broadway
Wichita, Kansas

Harper County, Sec. 21 Twp. 31S Rge. 7 (E) W (W)

NORTH

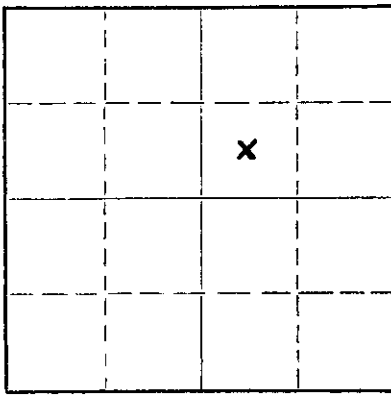

Locate well correctly on above
Section Plat

Location as "NE/CNW&SWK" or footage from lines SW NE
Lease Owner Bachus Oil Company
Lease Name Titus Well No. 1
Office Address 721 East Central, Wichita, Kansas
Character of Well (completed as Oil, Gas or Dry Hole) D & A
Date well completed 10-16 19 63
Application for plugging filed 10-16 19 63
Application for plugging approved 10-16 19 63
Plugging commenced 10-16 19 63
Plugging completed 8:15 P.M. 10-16 19 63
Reason for abandonment of well or producing formation D & A

If a producing well is abandoned, date of last production _____ 19____
Was permission obtained from the Conservation Division or its agents before plugging was commenced? Yes

Name of Conservation Agent who supervised plugging of this well Howard Hess
Producing formation _____ Depth to top _____ Bottom _____ Total Depth of Well 4822 Feet
Show depth and thickness of all water, oil and gas formations.

OIL, GAS OR WATER RECORDS

CASING RECORD

FORMATION	CONTENT	FROM	TO	SIZE	PUT IN	PULLED OUT
Mississippi	Dry	4402	4680	8 5/8"	222	-0-
Simpson	Dry	4797	4822			

Describe in detail the manner in which the well was plugged, indicating where the mud fluid was placed and the method or methods used in introducing it into the hole. If cement or other plugs were used, state the character of same and depth placed, from _____ feet to _____ feet for each plug set.

Filled hole with heavy mud from 4822 to 235

Set Plug No. 1 at 235' with 15 sacks cement and 1/2 sack of hulls

Filled hole with heavy mud to 40'

Set Plug No. 2 at 40' to surface with 8 sacks of cement and 1/2 sack of hulls.

Plug Rat hole with 2 sacks cement

RECEIVED
STATE CORPORATION COMMISSION

NOV 12 1963

CONSERVATION DIVISION
Wichita, Kansas

(If additional description is necessary, use BACK of this sheet)

Name of Plugging Contractor Bachus Oil Company
Address 721 East Central, Wichita, Kansas

STATE OF Kansas, COUNTY OF Sedgwick, ss.
Nelson R. Thomas (employee of owner) or (owner or operator) of the above-described

well, being first duly sworn on oath, says: That I have knowledge of the facts, statements, and matters herein contained and the log of the above-described well as filed and that the same are true and correct. So help me God.

(Signature) Nelson R. Thomas
721 East Central, Wichita, Kansas
(Address)

SUBSCRIBED AND SWORN TO before me this 11th day of November, 19 63

My commission expires Oct. 14, 1964.

Lovene C. Ehrsam
Lovene C. Ehrsam Notary Public.



TITUS NO. 1

Casing Record:

8 5/8 at 222
w 225 sacks cement
2% Calcium Chloride

Operator: Bachus Oil Company

Contractor: Bachus Oil Company

Commenced: October 2, 1963

Completed: October 16, 1963

Location: SW NE

Sec. 21-31S-7W
Harper County,
Kansas

Elevation: 1541 KB
1536 GL

Production: D & A

Formation:

From	To	
1	20	Sand
20	223	Red Bed Shale & Shells
223	586	Red Bed
586	772	Red Bed Shale & Shells
772	1285	Shale, Shells & Lime
1285	1640	Shale & Lime
1640	1748	Lime
1748	1925	Lime with Shale
1925	2055	Lime
2055	3019	Lime & Shale
3019	3238	Shale, Lime & Chalk
3238	3611	Shale & Lime
3611	3728	Sand & Shale
3728	3835	Lime & Shale
3835	4079	Lime
4079	4402	Lime & Shale
4402	4608	Miss Chat
4608	4667	Lime & Shale
4667	4718	Shale
4718	4783	Shale & Pyrite
4783	4798	Shale
4798	4822	Dolomite & Sand
	4822	Total Depth

Formation Tops:

Heebner	3308	(-1767)
Douglas	3400	(-1859)
Stalnaker	3611	(-2070)
Kansas City	3861	(-2320)
Mississippian	4402	(-2861)
Kinderhook	4680	(-3139)
Simpson Dolomite	4797	(-3256)
Simpson Sand	4810	(-3269)
Total Depth	4822	(-3281)

RECEIVED
STATE CORPORATION COMMISSION

NOV 12 1963

CONSERVATION DIVISION
Wichita, Kansas

I hereby certify that this is a true and correct copy of
the above log to the best of my knowledge.

Nelson R. Thomas
Nelson R. Thomas

Subscribed and sworn to before me

This 14th day of November, 1963

My Commission expires October 14, 1964

Lovena C. Ehram
Lovena C. Ehram
Notary Public