


Give All Information Completely
Make Required Affidavit
Mail or Deliver Report to:
Conservation Division
State Corporation Commission
212 No. Market
Wichita, Kansas

WELL PLUGGING RECORD

NORTH

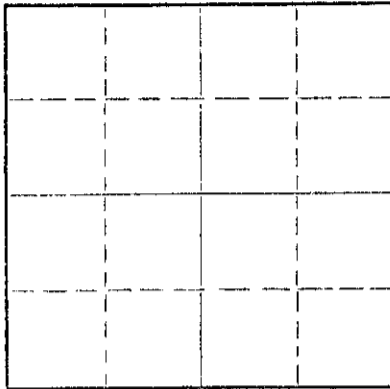

Locate well correctly on above
Section Plat

Harper County, Sec. 21 Twp. 31S Rge. 7W ~~W&X~~ (W)
Location as "NE/CNW&SWK" or footage from lines SE SE SE
Lease Owner Johnston Petroleum Corp. and Sterling Drilling Company
Lease Name Titus Well No. 1
Office Address 800 Continental Oil Building P. O. Box 129
Denver, Colorado 80202 Sterling, Kansas 67579
Character of Well (completed as Oil, Gas or Dry Hole) Dry Hole
Date well completed December 12, 1970 19
Application for plugging filed December 10, 1970 19
Application for plugging approved December 10, 1970 19
Plugging commenced 9:00 AM, December 12, 1970 19
Plugging completed 11:00 AM, December 12, 1970 19
Reason for abandonment of well or producing formation
Dry Hole
If a producing well is abandoned, date of last production 19
Was permission obtained from the Conservation Division or its agents before plugging was com-
menced? Yes

Name of Conservation Agent who supervised plugging of this well G. Russell Biberstein
Producing formation _____ Depth to top _____ Bottom _____ Total Depth of Well 4813 Feet
Show depth and thickness of all water, oil and gas formations.

OIL, GAS OR WATER RECORDS

CASING RECORD

FORMATION	CONTENT	FROM	TO	SIZE	PUT IN	PULLED OUT
				8 5/8"	241.98'	None

Describe in detail the manner in which the well was plugged, indicating where the mud fluid was placed and the method or methods used in introducing it into the hole. If cement or other plugs were used, state the character of same and depth placed, from _____ feet to _____ feet for each plug set.

Filled hole with heavy mud.
Filled hole to 230' - Plug and hulls -
25 sacks Cement - Mud to 40' - Set Plug
and hulls - 10 sacks cement. Plug rathole
with 2 sacks cement.

RECEIVED
STATE CORPORATION COMMISSION
DEC 15 1970
CONSERVATION DIVISION
Wichita, Kansas

(If additional description is necessary, use BACK of this sheet)

Name of Plugging Contractor Sterling Drilling Company
Address P. O. Box 129, Sterling, Kansas 67579

STATE OF KANSAS, COUNTY OF RICE, ss.
F. A. Wuellner, Secretary (employee of owner) or (owner or operator) of the above-described well, being first duly sworn on oath, says: That I have knowledge of the facts, statements, and matters herein contained and the log of the above-described well as filed and that the same are true and correct. So help me God. STERLING DRILLING COMPANY

(Signature) *F. A. Wuellner*
F. A. Wuellner, Secretary
P. O. Box 129, Sterling, Kansas 67579
(Address)

SUBSCRIBED AND SWORN TO before me this 14th day of December, 1970.

Bernard Lauder milk
Bernard Lauder milk, Notary Public.

My commission expires _____

STERLING DRILLING COMPANY
P. O. Box 129
Sterling, Kansas 67579

WELL LOG ----- Titus #1
Located: SE SE SE, Section 21-31-7W, Harper County, Kansas

OWNER: Johnston Petroleum Corporation and Sterling Drilling Company
ROTARY DRILLING CONTRACTOR: Sterling Drilling Company

COMMENCED: November 28, 1970
COMPLETED: December 9, 1970

TOTAL DEPTH: 4813'

<u>LOG</u>	<u>CASING RECORD</u>
0 - 75 Shale	Ran 6 joints 8 5/8" surface 241.98' cemented @ 253 K.E. with 250 sacks common cement with HA5. Plug down 9:15 PM, 11-28-70.
75 - 259 Shale, Red Bed	
259 - 325 Red Bed	
325 - 1205 Shale and Shells	
1205 - 1695 Lime and Shale	
1695 - 1868 Lime	
1868 - 3572 Lime and Shale	
3572 - 3589 Shale	
3589 - 3702 Sand	
3702 - 3930 Lime and Shale	
3930 - 4170 Lime	
4170 - 4240 Shale and Lime	
4240 - 4305 Lime, Sandy Shale	
4305 - 4370 Lime and Shale	
4370 - 4422 Lime and Shale, Chert	
4422 - 4660 Lime, Chert	
4660 - 4720 Lime	
4720 - 4788 Shale and Lime	
4788 - 4798 Simpson	
4798 - 4813 Sand	

Plugged.

RECEIVED
STATE CORPORATION COMMISSION
DEC 15 1970
CONSERVATION DIVISION
Wichita, Kansas