


STATE OF KANSAS
STATE CORPORATION COMMISSION

WELL PLUGGING RECORD

Give All Information Completely
Make Required Affidavit
Mail or Deliver Report to
Conservation Division
State Corporation Comm.
245 North Water
Wichita, KS 67202

Harper County. Sec. 34 Twp. 31S Rge. 7W E/W
Location as "NE/CNW 1/4 SW 1/4" or footage from lines SE NW NW
Lease Owner BEREN CORPORATION
Lease Name DRUMRIGHT Well No. 1
Office Address 970 Fourth Financial Center, Wichita, KS 67202
Character of Well (Completed as Oil, Gas or Dry Hole) dry hole
Date Well completed November 7, 1980 19
Application for plugging filed November 7, 1980 19
Application for plugging approved November 7, 1980 19
Plugging commenced November 7, 1980 19
Plugging completed November 7, 1980 19
Reason for abandonment of well or producing formation dry hole
If a producing well is abandoned, date of last production 19
Was permission obtained from the Conservation Division or its agents before plugging was commenced? yes
Name of Conservation Agent who supervised plugging of this well Don Thompson
Producing formation Depth to top Bottom Total Depth of Well 4795
Show depth and thickness of all water, oil and gas formations.

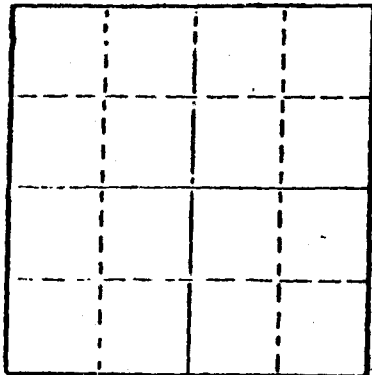

Locate well correctly on above Section Plat

OIL, GAS OR WATER RECORDS

CASING RECORD

FORMATION	CONTENT	FROM	TO	SIZE	PUT IN	PULLED OUT

Describe in detail the manner in which the well was plugged, indicating where the mud fluid was placed and the method or methods used in introducing it into the hold. If cement or other plugs were used, state the character of same and depth placed, from feet to feet for each plug set.

Hole plugged with 30 sacks commercial cement at 250',
12 sacks @ 40-0, 5 sacks in rat hole. Plugging completed
at 8:30 AM, November 7, 1980.

RECEIVED
STATE CORPORATION COMMISSION

DEC 10 1980

CONSERVATION DIVISION
Wichita, Kansas

(If additional description is necessary, use BACK of this sheet)

Name of Plugging Contractor BEREDCO INC.

STATE OF KANSAS COUNTY OF SEDGWICK, ss.
J. D. Marcus (employee of owner) or (owner or operator)
of the above-described well, being first duly sworn on oath, says: That I have knowledge of the facts, statements, and matters herein contained and the log of the above-described well as filed and that the same are true and correct. So help me God

(Signature)

970 Fourth Financial Center, Wichita, KS 67202
(Address)

SUBSCRIBED AND SWORN TO before me this 4th day of December, 19 80



My commission expires 4/27/81

Marca J. Dearth

ic.

DRILLERS LOG

DRUMRIGHT #1

SE NW NW
Section 34-31S-7W
Harper County, Kansas

Company: BEREN CORPORATION

Contractor: BEREDCO INC.

Comm: 10/29/80

Comp.: 11/7/80

Casing: 8 5/8", 24# set at 256' with 225 sacks pozmix, 3% gel, 2% CC, 60-40
DRY HOLE

<u>FORMATION</u>	<u>FROM</u>	<u>TO</u>
Sand Red Bed	0	818
Red Bed & Shale & Lime	818	1446
Lime & Shale	1446	3250
Lime, Shale & Sand	3250	3852
Lime & Shale	3852	4406
Lime, Shale & Chert	4406	4633
Lime & Shale	4633	4771
Simpson	4771	4795

Rotary Total Depth - 4795'

STATE OF KANSAS

ss:


COUNTY OF SEDGWICK

I certify that this is a true and correct copy of the above log as shown by the drilling reports.

BEREDCO

[Handwritten Signature]

Subscribed and sworn to before me this 4th day of December, 1980.

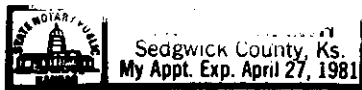

[Handwritten Signature]