

WELL PLUGGING RECORD

Give All Information Completely
Make Required Affidavit
Mail or Deliver Report to:
Conservation Division
State Corporation Commission
211 No. Broadway
Wichita, Kansas

RUSH

County. Sec. 12 Twp. 16 Rge. 17 (E) W (W)

Location as "NE/CNW/SW" or footage from lines. SW SW SW

Lease Owner PETROLEUM, INC.

Lease Name HERRMAN Well No. 1

Office Address Route 2, Great Bend, Kansas

Character of Well (completed as Oil, Gas or Dry Hole) Dry Hole

Date well completed September 23, 19 57

Application for plugging filed September 25, 19 57

Application for plugging approved September 23, 19 57


Plugging commenced September 23, 19 57

Plugging completed September 24, 19 57

Reason for abandonment of well or producing formation No producible zone

If a producing well is abandoned, date of last production None 19

Was permission obtained from the Conservation Division or its agents before plugging was commenced? Yes

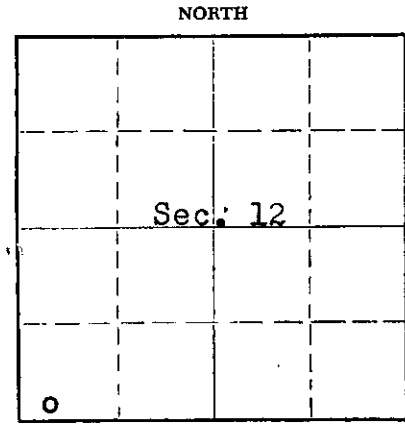

Locate well correctly on above Section Plat

Name of Conservation Agent who supervised plugging of this well R.M. Brundege, Hoisington, Kansas

Producing formation ----- Depth to top --- Bottom --- Total Depth of Well 3590 Feet

Show depth and thickness of all water, oil and gas formations.

OIL, GAS OR WATER RECORDS

CASING RECORD

FORMATION	CONTENT	FROM	TO	SIZE	PUT IN	PULLED OUT
				8-5/8"	378'	None

Describe in detail the manner in which the well was plugged, indicating where the mud fluid was placed and the method or methods used in introducing it into the hole. If cement or other plugs were used, state the character of same and depth placed, from _____ feet to _____ feet for each plug set.

Mud up with heavy mud to 750' followed by wooden plug. Placed 50 sacks cement through drill pipe on to plug. Mud up to 360' and placed 1/3 sack hulls at 360' followed by wooden plug and 20 sacks cement. Mud up to 20' and placed 1/3 sack hulls at 20' followed by wooden plug and 5 sacks cement to base of well cellar.

(If additional description is necessary, use BACK of this sheet)

Name of Plugging Contractor Garvey Drilling Company

Address Route 2, Great Bend, Kansas

STATE OF KANSAS, COUNTY OF BARTON, ss.

Don Searle (employee of owner) or (~~representative~~) of the above-described well, being first duly sworn on oath, says: That I have knowledge of the facts, statements, and matters herein contained and the log of the above-described well as filed and that the same are true and correct. So help me God.

(Signature) Don Searle

Route 2, Great Bend, Kansas
(Address)

SUBSCRIBED AND SWORN TO before me this 4th day of October, 19 57

Red J. Brown
Notary Public.

My commission expires July 11, 1960

PLUGGING
FILE SEC 12 T 16 R 17W
BOOK PAGE 48 LINE 30

10-07-1957
DIVISION
KANSAS

WELL LOG

15-145-01899-00-00

COMPANY PETROLEUM, INCORPORATED

SEC. 12 T. 16S R. 17W

FARM HERRMAN NO. 1


LOC. SW, SW, SW

TOTAL DEPTH 3590'

COUNTY Rush Co., Kansas

COMM. September 13, 1957 COMP. September 24, 1957

CONTRACTOR GARVEY DRILLING COMPANY

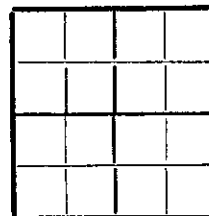

CASING 8 5/8" @ 378' W/200 sax.

ELEVATION

PRODUCTION D & A

FIGURES INDICATE BOTTOM OF FORMATIONS

40	Surface soil
378	Shale, sand & clay
505	Shale
550	Sand
1107	Red bed & shale
1140	Anhydrite
1455	Shale
1910	Shale & shells
3195	Lime & shale
3515	Lime
3583	Lime & shale
3590	Lime
3590	T. D.

PLUGGING
 FILE SEC. 12 T. 16 R. 17W
 BOOK PAGE 48 LINE 30

RECEIVED
 STATE COMMISSION
 10-07-1957
 OCT 7 - 1957

COMMISSION DIVISION
 STATE OF KANSAS

State of KANSAS }
 County of BARTON } ss:

I, Verne A. Morris of Garvey Drilling Co.

upon oath state that the above and foregoing is a true and correct copy of the log of the #1 Herrman well

Verne A. Morris

Subscribed and sworn to before me this 3rd day of October 19 57

My Commission Expires July 11, 1960

Red T. Brown
 NOTARY PUBLIC