


STATE OF KANSAS
STATE CORPORATION COMMISSION

WELL PLUGGING RECORD

Give All Information Completely
Make Required Affidavit
Mail or Deliver Report to
Conservation Division
State Corporation Comm.
245 North Water
Wichita, KS 67202

Rush County, Sec. 20 Twp. 19S Rge. 19W 1/2/W
Location as "NE/CNW 1/4 SW 1/4" or footage from lines
SW/4 SE/4 SW/4
Lease Owner Gear Petroleum Company
Lease Name Seltman Well No. 1
Office Address 300 Sutton Place, Wichita, Kansas 67202
Character of Well (Completed as Oil, Gas or Dry Hole) _____

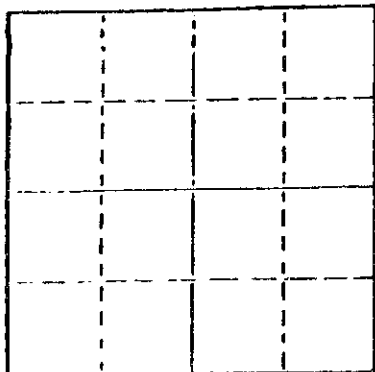

Locate well correctly on above
Section Plat

D & A
Date Well completed April 27, 1979
Application for plugging filed April 27, 1979
Application for plugging approved April 27, 1979
Plugging commenced April 28, 1979
Plugging completed April 28, 1979
Reason for abandonment of well or producing formation _____

D & A
If a producing well is abandoned, date of last production 19 _____

Was permission obtained from the Conservation Division or its agents before plugging was commenced? Yes

Name of Conservation Agent who supervised plugging of this well Leo F. Massey
Producing formation _____ Depth to top _____ Bottom _____ Total Depth of Well 4,350'
Show depth and thickness of all water, oil and gas formations.

OIL, GAS OR WATER RECORDS

CASING RECORD

FORMATION	CONTENT	FROM	TO	SIZE	PUT IN	PULLED OUT
				8 5/8"	409.81'	-0-

Describe in detail the manner in which the well was plugged, indicating where the mud fluid was placed and the method or methods used in introducing it into the hold. If cement or other plugs were used, state the character of same and depth placed, from _____ feet to _____ feet for each plug set.

1st Plug @ 550' w/70 sx cement
2nd Plug @ 240' w/20 sx cement
3rd Plug, bridge & plug @ 40' w/10 sx cement
(Cement - 50-50 Pozmix, 2% Gel)

(If additional description is necessary, use BACK of this sheet)

Name of Plugging Contractor Red Tiger Drilling Company
1720 KSB&T Building


STATE OF Kansas COUNTY OF Sedgwick, ss. contractor
Gloria Fawcett (employee of ~~xxxxxx~~)
of the above-described well, being first duly sworn on oath, says: That I have knowledge of the facts, statements, and matters herein contained and the log of the above-described well as filed and that the same are true and correct. So help me God.

(Signature) Gloria Fawcett
1720 KSB&T Building, Wichita, Kansas 67202
(Address)

SUBSCRIBED AND SWORN TO before me this 30th day of April, 1979.

My commission expires _____

Joyce A. Hagermann
Notary Public.
STATE CORPORATION COMMISSION

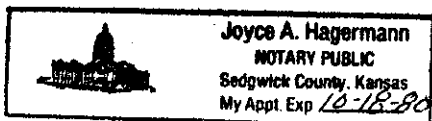

MAY - 7 1979
5-7-79
CONSERVATION DIVISION
Wichita, Kansas

15-165-20718-0000

DRILLERS LOG

No. 1 Seltman

CASING RECORD:	COMPANY:	Gear Petroleum Company	DESCRIPTION:
8 5/8" @ 409.81'	CONTRACTOR:	Red Tiger Drilling Company	SW/4 SE/4 SW/4
w/225 sx cement	COMMENCED:	April 18, 1979	Sec. 20-T19S-R19W
	COMPLETED:	April 28, 1979	Rush County, Kansas
TOTAL DEPTH: 4,350'			ELEVATION: 2,250' GL

<u>FORMATION</u>	<u>FROM</u>	<u>TO</u>	<u>REMARKS</u>
Surface Soil	0	305	
Shells & Shale	305	410	
Shale	410	855	
Sand	855	1072	
Shale	1072	1451	
Anhydrite	1451	1471	
Shale	1471	2055	
Lime & Shale	2055	2300	
Shale	2300	2490	
Shale & Lime	2490	2675	
Lime & Shale	2675	3700	
Lime	3700	4350	
RTD		4350	

I certify that this is a true and correct copy of the above log to the best of my knowledge.

RED TIGER DRILLING COMPANY

Gloria Fawcett
Gloria Fawcett

Subscribed and sworn to before me this 30th day of April, 1979.

Joyce A. Hagermann
Notary Public

