

15-165-30026-0000

WELL PLUGGING RECORD

Give All Information Completely
Make Required Affidavit
Mail or Deliver Report to:
Conservation Division
State Corporation Commission
211 No. Broadway
Wichita, Kansas

Rush County. Sec. 19 Twp. 19S Rge. (E) 19 (W)

Location as "NE/CNW/SW" or footage from lines Ctr. NE SW

Lease Owner Graybol Oil Corporation

Lease Name Seltmann Well No. 1

Office Address 2200 N.B.T. Bldg., Tulsa, Oklahoma 74103

Character of Well (completed as Oil, Gas or Dry Hole) Dry hole

Date well completed August 7 19 65

Application for plugging filed August 7 19 65

Application for plugging approved August 7 19 65


Plugging commenced August 7 19 65

Plugging completed August 7 19 65

Reason for abandonment of well or producing formation

If a producing well is abandoned, date of last production 19

Was permission obtained from the Conservation Division or its agents before plugging was commenced? Yes

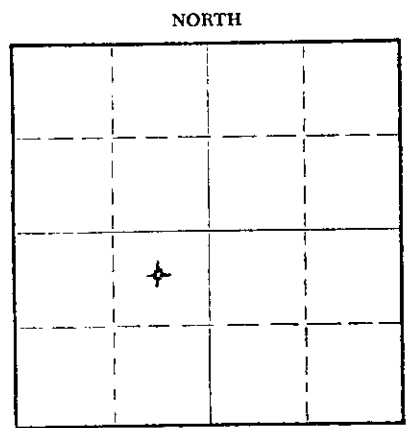

Locate well correctly on above Section Plat

Name of Conservation Agent who supervised plugging of this well Eldon Petty

Producing formation Depth to top Bottom Total Depth of Well 4325 Feet

Show depth and thickness of all water, oil and gas formations.

OIL, GAS OR WATER RECORDS

CASING RECORD

FORMATION	CONTENT	FROM	TO	SIZE	PUT IN	PULLED OUT
Lansing limestone	Water	3823	4116	8 5/8"	245'	None
Cherokee sand	Water	4294	4325			

Describe in detail the manner in which the well was plugged, indicating where the mud fluid was placed and the method or methods used in introducing it into the hole. If cement or other plugs were used, state the character of same and depth placed, from feet to feet for each plug set.

Filled hole with heavy mud-laden fluid to 540'. Inserted 20 sacks of Portland cement. Filled hole with heavy mud-laden fluid to 240'. Inserted 20 sacks of Portland cement. Filled hole with heavy mud-laden fluid to 40'. Inserted ten sacks of Portland cement, filling hole to surface. Placed two sacks of Portland cement in rat-hole. Used pump truck of Globe Cementing Company in plugging.

RECEIVED
OCT 10 1965
8-10-65
CONSERVATION DIVISION
WICHITA, KANSAS

(If additional description is necessary, use BACK of this sheet)

Name of Plugging Contractor Graybol Oil Corporation

Address as above

STATE OF OKLAHOMA, COUNTY OF TULSA, ss.

Lyman C. Dennis (employee of owner) or (owner or operator) of the above-described well, being first duly sworn on oath, says: That I have knowledge of the facts, statements, and matters herein contained and the log of the above-described well as filed and that the same are true and correct. So help me God.

(Signature) Lyman C. Dennis

Tulsa, Oklahoma (Address)

SUBSCRIBED AND SWORN TO before me this 9th day of August 19 65

Handwritten signature of Notary Public

Notary Public.

My commission expires October 2, 1967

GRAYCOL OIL CORPORATION

Rush County, Kansas

No. 1 Seltmann

Ctr. NE SW Sec. 19-19S-19W

Contractor: Company Tools

Elev. 2221 K.B. & D.F., 2215 G.L.

Commenced: July 27, 1965

Completed: August 7, 1965

Production: Dry and Abandoned

CASING RECORD

8 5/8" surface casing set at 245' with 150 sacks of cement.

<u>DEPTH</u>	<u>FORMATION</u>	<u>WELEX ELECTROLOG TOPS:</u>	
0-60	Clay	Stone Corral anhydrite	1419 (+802)
60-251	Shale and shells	Peebner shale	3777 (-1556)
251-839	Red bed, shale and shells	Lansing limestone	3823 (-1602)
839-1060	Sand	Base of Kansas City	4116 (-1895)
1060-1419	Red bed, shale and shells	Pawnee limestone	4202 (-1981)
1419-1455	Anhydrite	Fort Scott limestone	4240 (-2019)
1455-1805	Shale and shells	Cherokee shale	4261 (-2040)
1805-2150	Shale	Cherokee sand	4294 (-2073)
2150-2241	Shale and lime	Welex Total Depth	4329.
2241-2545	Lime and shale		
2545-2605	Lime	No cores or drill stem tests taken.	
2605-3835	Lime and shale		
3835-4057	Lime		
4057-4114	Lime and shale		
4114-4145	Lime		
4145-4155	Lime and shale		
4155-4202	Lime		
4202-4245	Lime and shale		
4245-4287	Lime		
4287-4325	Lime, chert and shale		
4325	Driller's Total Depth		

RECEIVED
STATE CORPORATION COMMISSION

AUG 10 1965

8-10-65

CONSERVATION DIVISION
Wichita, Kansas

I hereby certify that the above is a true and correct log of the above-captioned test as taken directly from the daily drilling reports.

GRAYCOL OIL CORPORATION

BY: Lyman C. Dennis
Lyman C. Dennis, Geologist

STATE OF OKLAHOMA

COUNTY OF TULSA

Subscribed and sworn to this 9th day of August, 1965.My commission expires: October 2, 1967

Nancy Ann Ellis
NOTARY PUBLIC